

SURVEY & REMONUMENTATION

OCT 19 1999

1998 ALPENA COUNTY REMONUMENTATION CORNER

Liber 00002 Page 0181

SECTION

LAND CORNER RECORDATION CERTIFICATE
Filing Requirement of Act 74, Mich. P.A. 1970

For corners in

Alpena (County)	Located In:	Corner Code #
1. Public Land Survey	T 29NR 7E	K-11
	T ___ R ___	Ossineke Twp.
	T ___ R ___	
	T ___ R ___	
2. Property Controlling in Section	S ___ T ___ R ___	
	S ___ T ___ R ___	
3. Miscellaneous Property in Sec.	S ___ T ___ R ___	
	S ___ T ___ R ___	

STATE OF MICHIGAN
County of Alpena
Recorded
12-22-1998 12:44:00
Kathy J. Matak
REGISTER OF DEEDS

Register of Deeds Stamp & File Number

4. Lot No. _____, Recorded Plat _____
5. Private Claims _____

I, Thomas L. Fabis, in a field survey on Dec. 4, 19 98 do hereby state that under requirements of P.A. 74, Michigan P.A. of 1970, the corner points mentioned in lines 1 and 2 above were in conformance with regulations and rules therefore as required in the current manual of survey instructions of the United States Department of the Interior, Bureau of Land Management or by a decree of a Court of Law and/or that the corner points mentioned in lines 3, 4 and 5 above were in conformance with the rules of the Michigan Board of Land Surveyors or by a Decree of a Court of Law, established, re-established, monumented, recovered, found as expressed below:

NOTE: Not more than 2 corners, all in the same town and range, may be recorded on this certificate.

	A	B	C	D	E	F	G	H	I	J	K	L	M
1													
2		6		5		4		3		2		1	
3													
4		7		8		9		10		11		12	
5													
6		18		17		16		15		14		13	
7													
8		19		20		21		22		23		24	
9													
10		30		29		28		27		26		25	
11													
12		31		32		33		34		35		36	
13													

A. Description of original monument and accessories and/or subsequent restoration:

- 1839: G.L.O. Survey Lewis Clason Set post & referenced: Y. Pine 15 S68 1/2 E 28, W. Pine 28 N9 1/2 W 22.
- 1904: County Survey Jos. McNeil 3/4" sq. iron pin, O.B.T.'s still visible.
- 1913: County Survey Jos. McNeil same as 1904.
- 1961: R.S.Scott Eng. Co. Rd. Surv. W.O.4-2097 James Scott Fd. 5/8" sq. iron rod & referenced.
- 1972: Green Oaks Plat James Scott measured from the East.
- 1986: Survey W.O.4-349 Earl Lewis Existing 1/2" Rod & referenced.
- 1996: Survey W.O. 0402965S Wayne Lewis Exist. Pipe & referenced.

P.A. 345 ALPENA COUNTY
PEER APPROVED 12/17/98
D. R. [Signature]

B. Description of corner evidence found and/or method applied in restoring or reestablishing corner:


- 1998: Found 1/2" iron rod with unknown cap in centerline of Scott Rd. (gravel surface). Also, found Wayne Lewis Tags in three existing witnesses: 7" W. Pine S20E 35.00', 8" R. Pine S44W 40.14', and 6" White Oak N60W 64.60'. Also found old witness tree: 18" Oak North 39.21' with no existing tag.

The position of this corner is compatible with county and local surveys and is accepted as a careful and faithful perpetuation of the position of the original corner.

C. Description of monument for corner and accessories established to perpetuate locating the position of the corner:

- 1998: Set 3" dia. alum. cap, stamped to identify the corner over the existing 1/2" iron rod. Witnesses are:
Ex. W.T.L. Tag in 7" W. Pine S20E 35.00'
Ex. W.T.L. Tag in 8" R. Pine S44W 40.14'
Ex. W.T.L. Tag in 6" White Oak N60W 64.60'
Set Fabis Tag in 18" Oak North 39.21'

Signed by Thomas L. Fabis
Surveyor's Michigan License No. 31591

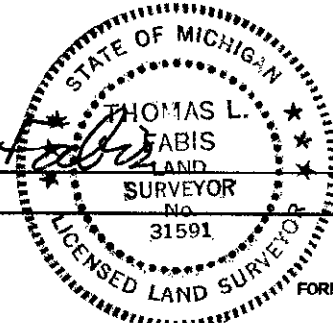

Date December 21, 1998