

**2000 Alpena County Remonumentation Corner  
LAND CORNER RECORDATION CERTIFICATE**  
Filing Requirement of Act 74, Mich. P.A. 1970

For corners in

|  |                         |               |
|--|-------------------------|---------------|
| <u>Alpena</u><br><small>(County)</small> | Located In:             | Corner Code # |
| 1. Public Land Survey                    | T 29N R8E               | A-8           |
|  | T 29N R7E               | M-8           |
|  | T _____ R _____         |               |
|  | T _____ R _____         |               |
| 2. Property Controlling<br>in Section    | S _____ T _____ R _____ |               |
|  | S _____ T _____ R _____ |               |
| 3. Miscellaneous<br>Property in Sec.     | S _____ T _____ R _____ |               |
|  | S _____ T _____ R _____ |               |



**L- 2 P- 333**  
08/16/2000 09:32A  
Page: 1 of 1  
Kathy J. Matash, Register Alpena Co., MI LDC 9.00  
Register of Deeds Stamp & File Number

4. Lot No. \_\_\_\_\_, Recorded Plat \_\_\_\_\_  
5. Private Claims \_\_\_\_\_

I, Daniel T. Kibbe, in a field survey on March 8, 2000 do hereby state that under requirements of P.A. 74, Michigan P.A. of 1970, the corner points mentioned in lines 1 and 2 above were in conformance with regulations and rules therefore as required in the current manual of survey instructions of the United States Department of the Interior, Bureau of Land Management or by a decree of a Court of Law and /or that the corner points mentioned in lines 3, 4 and 5 above were in conformance with the rules of the Michigan Board of Land Surveyors or by a Decree of a Court of Law; established, re-established, monumented, recovered, found as expressed below:

|    |    |   |    |   |    |   |    |   |    |   |    |   |   |
|----|----|---|----|---|----|---|----|---|----|---|----|---|---|
|    | A  | B | C  | D | E  | F | G  | H | I  | J | K  | L | M |
| 1  |    |   |    |   |    |   |    |   |    |   |    |   |   |
| 2  | 6  |   | 5  |   | 4  |   | 3  |   | 2  |   | 1  |   |   |
| 3  |    |   |    |   |    |   |    |   |    |   |    |   |   |
| 4  | 7  |   | 8  |   | 9  |   | 10 |   | 11 |   | 12 |   |   |
| 5  |    |   |    |   |    |   |    |   |    |   |    |   |   |
| 6  | 18 |   | 17 |   | 16 |   | 15 |   | 14 |   | 13 |   |   |
| 7  |    |   |    |   |    |   |    |   |    |   |    |   |   |
| 8  | 19 |   | 20 |   | 21 |   | 22 |   | 23 |   | 24 |   |   |
| 9  |    |   |    |   |    |   |    |   |    |   |    |   |   |
| 10 | 30 |   | 29 |   | 28 |   | 27 |   | 26 |   | 25 |   |   |
| 11 |    |   |    |   |    |   |    |   |    |   |    |   |   |
| 12 | 31 |   | 32 |   | 33 |   | 34 |   | 35 |   | 36 |   |   |
| 13 |    |   |    |   |    |   |    |   |    |   |    |   |   |

**NOTE: Not more than 2 corners, all in the same town and range, may be recorded on this certificate.**

**A. Description of original monument and accessories and/or subsequent restoration:**

- 1839: GLO Survey by Lewis Clawson Set quarter post. Referenced: Beech 12-N64°W-46 Aspen 11-S45°W-26
- 1905: County Survey by Jos. W. McNeil Found an old stake standing and remains of one obt. Set new cedar stake 3" sq. Did not make any nwt's. Referenced: Beech 12-N64°W-46
- 1973: Survey by Edward LaCross Set Iron. Referenced: 6" Maple-East-32.75'/10" Willow-West-65.05'
- 1994: Survey by Earl T. Lewis Existing 1/2" rerod Referenced: 14" Maple-East-33.10' 10" Maple-N80°E-33.10' Power Pole-S30°E-147.30' Power Pole-S30°W-107.65'
- 1997: Survey by David B. Guthrie Found Existing 1/2" rebar

P.A. 345 ALPENA COUNTY  
PEER APPROVED 7-12-2000  
*D.B. Guthrie*

**B. Description of corner evidence found and/or method applied in restoring or reestablishing corner:**

Found 1/2" rebar.

This corner position is compatible with county & local surveys. This corner position is accepted as a careful and faithful perpetuation of the position of the original corner.

**C. Description of monument for corner and accessories established to perpetuate locating the position of the corner:**

- 2000: Placed 3" Alpena County cap stamped to identify the corner over 1/2" iron rod 6" below grade. Referenced: Set tag in fence post-N47°W-38.56' Set tag in fence post-S54°W-38.02' Set tag over nail and flagging in 12" twin maple-N74°E-33.03' Set tag over nail and flagging in 12" twin maple-N85°E-33.18'


Signed by *Daniel T. Kibbe*  
Surveyor's Michigan License No. 37278

Date August 14, 2000

PROFESSIONAL SURVEYORS, JAN. 28, 1971

**SURVEY &  
REMONUMENTATION**

REVISED MAY 14, 1995

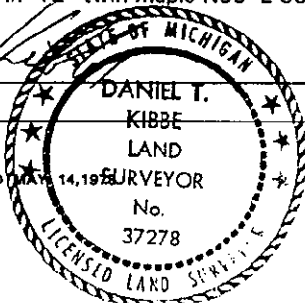

FORM APPROVED BY MICHIGAN STATE BOARD OF

REVISED JAN., 1983  
REVISED OCT., 1995

**JAN 25 2001**

**SECTION**