## LAND CORNER RECORDATION CERTIFICATE Filing Requirement of Act 74, Mich. P.A. 1970

For	r corners in  ALPINA County		Located In:	Corner Code 11
	Countyr			
1.	Public Land Survey		<sub>T</sub> 29N <sub>R</sub> 8E	M-6
			T .R	
2	Property Controlling	s 1	3 <sub>T</sub> 29N <sub>R</sub> 8E	7/M-5
	in Section	S	T , R ,	
3	Miscellaneous	S	T R	

Register of Deeds Stamp & File Number


4. Lot No. , Recorded Plat


5. Private Claims

Property in Sec

do hereby certify that under requirements of P.A. 74, Michigan P.A. of 1970, the corner points mentioned in lines 1 and 2 above were in conformance with regulations and rules therefore as required in the current manual of survey instructions of the United States Department of the Interior, Bureau of Land Management or by a decree of a Court of Law and/or that the corner points mentioned in lines 3, 4 and 5 above were in conformance with the rules of the Michigan Board of Land Surveyors or by a Decree of a Court of Law; established, re-established, monumented, re-monumented, recovered, found as expressed below

NOTE: Not more than 4 corners, all in the same town and range, may be recorded on this certificate.

 

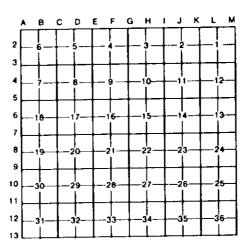

B Description of corner evidence found and/or method applied in restoring or reestablishing corner:
 M-6 - Fd. very old squared part in edge of roadfill. Origin unknown, but fits well with other corners of section 13, and considered acceptable in this survey.

7/M-5 - Set corner by standard survey procedure for the subdivision of sections.

C Description of monument for corner and accessories established to perpetuate locating the position of the corner;

M-6
Set 5/8" rod w/RLS cap
6" Cedar S17°W 57.5'
8" Cedar N75°E 60.5'

7/M-5
Set 5/8" rod w/RLS cap
20" Ash N55°W
20" Ash S45°W



OF MICH G

A JOHNSON

LAND

A LAND

No.

30083

No.

30083

Signed by

Surveyor's Michigan License No

30083

Date 6/2

FORM APPROVED BY MICHIGAN STATE BOARD OF LAND SURVEYORS, JAN. 28, 1975

REVISED MAY 14, 1975 REVISED JAN., 1983