

LAND CORNER RECORDATION CERTIFICATE
Filing Requirement of Act 74, Mich. P.A. 1970

SECTION

For corners in

Alpena
(County)


Located In:

Corner Code #



L- 2 P- 231
11/22/1999 01:43P
Page: 1 of 1
Kathy J. Matash, Register Alpena Co., MI LDC 9.00

- 1. Public Land Survey T29N R 8E B-11
 T R Sanborn Twp.
- 2. Property Controlling S T R
 in Section S T R
- 3. Miscellaneous S T R
 Property in Sec. S T R

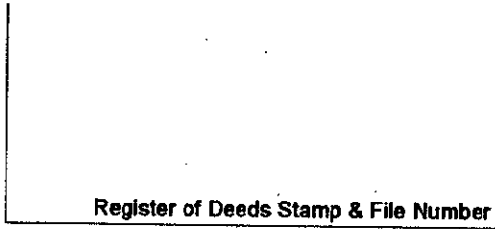

- 4. Lot No. _____, Recorded Plat _____
- 5. Private Claims _____

I, Thomas L. Fabis, in a field survey on July 27, 1999 do hereby state that under requirements of P.A. 74, Michigan P.A. of 1970, the corner points mentioned in lines 1 and 2 above were in conformance with regulations and rules therefore as required in the current manual of survey instructions of the United States Department of the Interior, Bureau of Land Management or by a decree of a Court of Law and/or that the corner points mentioned in lines 3, 4 and 5 above were in conformance with the rules of the Michigan Board of Land Surveyors or by a Decree of a Court of Law; established, re-established, monumented, recovered, found as expressed below:

NOTE: Not more than 2 corners, all in the same town and range, may be recorded on this certificate.


	A	B	C	D	E	F	G	H	I	J	K	L	M
1													
2	6		5		4		3		2		1		
3													
4	7		8		9		10		11		12		
5													
6	18		17		16		15		14		13		
7													
8	19		20		21		22		23		24		
9													
10	30		29		28		27		26		25		
11	●												
12	31		32		33		34		35		36		
13													

- A. Description of original monument and accessories and/or subsequent restoration:
 - 1839: G.L.O. Survey Lewis Clason set post & referenced: W. Pine 42 N62E 23, Red Maple 10 S29W 51.
 - 1906: County Survey Jos. W. McNeil set 1/4 S. 30 and 31 large cedar stake.
 - 1973: R.S. Scott Eng. Co. Don Marlatt found Mon. & referenced.
 - 1970's: Alpena Co. Rd. Comm. Record Book Gary St. Charles found 1/2" iron in concrete and referenced.
 - 1994: Thomas R. Hendricks P.E. Survey by Thomas Fabis found 1/2" iron rod & referenced.

- B. Description of corner evidence found and/or method applied in restoring or reestablishing corner:
 - 1999: Found 1/2" iron rod bent in concrete with double head nail at base. Found 3 existing witnesses matching witnesses from the 1994 Thomas R. Hendricks Survey by Fabis.

The position of this corner is compatible with county and local surveys and is accepted as a careful and faithful perpetuation of the position of the original corner.

- C. Description of monument for corner and accessories established to perpetuate locating the position of the corner:
 - 1999: Straightened the existing 1/2" iron rod in concrete and set a 3" dia. alum. cap, stamped to identify the corner, over it. Witnesses with tag P.S. #31591 are as follows:
 - P. Pole S2W 30.72
 - 8" W. Pine S40E 49.58
 - 5" W. Pine N22E 43.49
 - 13" Oak N20W 37.40

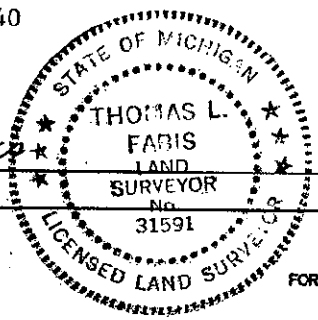

P.A. 345 ALPENA COUNTY
PEER APPROVED 8/24/99
Del B. ...

Signed by Thomas L. Fabis
Surveyor's Michigan License No. 31591

Date November 19, 1999