

MAY 16 1997

LAND CORNER RECORDATION CERTIFICATE
Filing Requirement of Act 74, Mich. P.A. 1970


STATE OF MICHIGAN
County of Alpena
Recorded
10-17-1996 11:45:1
Kathy J. Matash
REGISTER OF DEEDS

For corners in

| Alpena (County) | Located In: | Corner Code # |
|---------------------------------------|-------------|---------------|
| 1. Public Land Survey | T 29N R 8E | C-3 |
| | T R | |
| | T R | |
| | T R | |
| 2. Property Controlling in Section | S T R | |
| | S T R | |
| 3. Miscellaneous Property in Sec. | S T R | |
| | S T R | |

Liber 00002 Page 0056
Register of Deeds Stamp & File Number

- 4. Lot No. _____ Recorded Plat _____
- 5. Private Claims _____

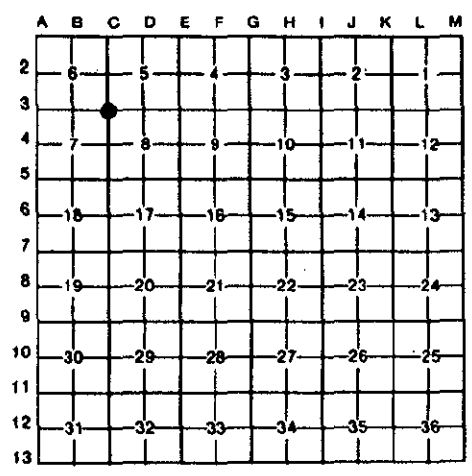

I, Daniel T. Kibbe in a field survey on June 14, 1996, do hereby certify that under requirements of P.A. 74, Michigan P.A. of 1970, the corner points mentioned in lines 1 and 2 above were in conformance with regulations and rules therefore as required in the current manual of survey instructions of the United States Department of the Interior, Bureau of Land Management or by a decree of a Court of Law and/or that the corner points mentioned in lines 3, 4 and 5 above were in conformance with the rules of the Michigan Board of Land Surveyors or by a Decree of a Court of Law; established, re-established, monumented, re-monumented, recovered, found as expressed below:

NOTE: Not more than 4 corners, all in the same town and range, may be recorded on this certificate.

- A. Description of original monument and accessories and/or subsequent restoration:
- 1839: GLO Survey by Lewis Clason - set post & referenced: Cedar 12 - S 54 E - 17, Ash 9 - N 8 W - 09.
 - 1902: County Survey by Jos. W. McNeil - in center of road bed.
 - 1904: County Survey by Jos. W. McNeil - large stake buried 2' in center of road.
 - 1907: County Survey by Jos. W. McNeil - in road bed.
 - 1972: Alpena County Road Commission records - found 1/2" pipe & referenced.
 - 1981: Survey by Duane MacNeill - found 1" pipe.
 - 1984: Survey by Earl Lewis - referenced existing 3/4" pipe.
 - 1988: Survey by Earl Lewis - referenced existing 3/4" pipe.

- B. Description of corner evidence found and/or method applied in restoring or reestablishing corner:
- 1996: Found 3/4" pipe with nail inside located 1.6' W. of C/L Spruce Rd. and 1' N. of C/L Beaver Lake Rd.

This corner position is compatible with county and local surveys and agrees with Alpena County records. This corner position is accepted as a careful and faithful perpetuation of the position of the original corner.

P.A. 345 ALPENA COUNTY
PEER APPROVED 7/18/96
D. B. Lee

- C. Description of monument for corner and accessories established to perpetuate locating the position of the corner:
- 1996: Placed 3" Alpena County cap stamped to identify the corner over 1/2" iron rod inside existing 3/4" pipe, 6" below grade.
Referenced:
S 59° W - 48.00' - Set N/Tag over found tack in Power Pole
S 48° E - 39.85' - Set N/Tag over found tack in Power Pole
N 30° W - 54.05' - Set N/Tag in corner fence post
N 71° E - 37.54' - Set N/Tag in fence post



Signed by *Daniel T. Kibbe* Date October 15, 1996
Surveyor's Michigan License No. 37278