

MAY 16 1997

1996 Alpena County Remonumentation Corner

LAND CORNER RECORDATION CERTIFICATE
Filing Requirement of Act 74, Mich. P.A. 1970

STATE OF MICHIGAN
County of Alpena
Recorded
10-17-1996 11:46:11
Kathy J. Matash
REGISTER OF DEEDS

For corners in

Alpena

(County)

Located In:

Corner Code #

- 1. Public Land Survey T 29NR 8E C-9
2. Property Controlling in Section S T R
3. Miscellaneous Property in Sec. S T R

Liber 00002 Page 0061
Register of Deeds Stamp & File Number

- 4. Lot No. Recorded Plat
5. Private Claims

Grid table with columns A-M and rows 2-13. A dot is marked at row 9, column C.

I, Daniel T. Kibbe in a field survey on July 1, 1996 do hereby certify that under requirements of P.A. 74, Michigan P.A. of 1970, the corner points mentioned in lines 1 and 2 above were in conformance with regulations and rules therefore as required in the current manual of survey instructions of the United States Department of the Interior, Bureau of Land Management or by a decree of a Court of Law and/or that the corner points mentioned in lines 3, 4 and 5 above were in conformance with the rules of the Michigan Board of Land Surveyors or by a Decree of a Court of Law; established, re-established, monumented, re-monumented, recovered, found as expressed below:


NOTE: Not more than 4 corners, all in the same town and range, may be recorded on this certificate.

- A. Description of original monument and accessories and/or subsequent restoration:
1839: GLO Survey by Lewis Clason - set post & referenced: Hemlock 12 - N 30 W - 3 Hemlock 16 - S 50 1/2 E - 83.
1902: County Survey by Jos. W. McNeil - set new large cedar stake.
1905: County Survey by Jos. W. McNeil - in road bed.
1910: County Survey by Jos. W. McNeil - in cross roads.
1960±: Spruce Rd. plans on file at Alpena County Road Commission.
1973: Survey by Edward LaCross - found iron & referenced.
1983: Survey by Earl Lewis - referenced existing 1/2" rod.
1988: Survey by John Oliver - found 3/8" rod.
1994: Survey by Tom Fabis - referenced ex. 5/8" iron in C/L paved road.
B. Description of corner evidence found and/or method applied in restoring or reestablishing corner:
1996: Found 5/8" rebar located at C/L "X" Spruce Rd. and Kitter Rd.

This corner position is compatible with county and local surveys. This corner position is accepted as a careful and faithful perpetuation of the position of the original corner.

P.A. 345 ALPENA COUNTY
PEER APPROVED 7/18/96
[Signature]

- C. Description of monument for corner and accessories established to perpetuate locating the position of the corner:
1996: Placed 3" Alpena County cap stamped to identify the corner over 1/2" iron rod in monument box.
Referenced:
N 52° W - 68.41' - Fd. N/Tag in fence post
S 60° W - 62.03' - Fd. N/Tag in Power Pole
S 62° E - 69.66' - Fd. N/Tag in 4" Red Pine
S 48° E - 73.03' - Fd. N/Tag in 6" Red Pine

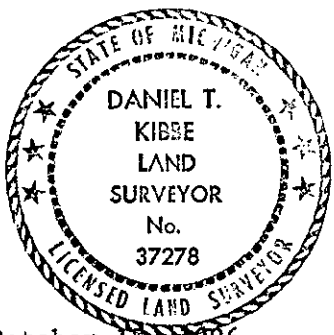

Signed by [Signature] Date October 15, 1996

Surveyor's Michigan License No. 37278