

JAN 21 2000

1999 ALPENA COUNTY REMONUMENTATION CORNER

LAND CORNER RECORDATION CERTIFICATE  
Filing Requirement of Act 74, Mich. P.A. 1970

SECTION

For corners in

Alpena  
(County)

Located In:

Corner Code #



L-2 P-240  
11/22/1999 01:43P  
Page: 1 of 1  
Kathy J. Matash, Register Alpena Co., MI LDC 9.00

- 1. Public Land Survey T29N R8E E-9  
T R Sanborn Twp.
- 2. Property Controlling in Section S T R
- 3. Miscellaneous Property in Sec. S T R

Register of Deeds Stamp & File Number

- 4. Lot No. \_\_\_\_\_, Recorded Plat \_\_\_\_\_
- 5. Private Claims \_\_\_\_\_

	A	B	C	D	E	F	G	H	I	J	K	L	M
1													
2	6		5		4		3		2		1		
3													
4	7		8		9		10		11		12		
5													
6	16		17		16		15		14		13		
7													
8	19		20		21		22		23		24		
9													
10	30		29		28		27		26		25		
11													
12	31		32		33		34		35		36		
13													

I, Thomas L. Fabis, in a field survey on July 27, 1999 do hereby state that under requirements of P.A. 74, Michigan P.A. of 1970, the corner points mentioned in lines 1 and 2 above were in conformance with regulations and rules therefore as required in the current manual of survey instructions of the United States Department of the Interior, Bureau of Land Management or by a decree of a Court of Law and/or that the corner points mentioned in lines 3, 4 and 5 above were in conformance with the rules of the Michigan Board of Land Surveyors or by a Decree of a Court of Law; established, re-established, monumented, recovered, found as expressed below:

NOTE: Not more than 2 corners, all in the same town and range, may be recorded on this certificate.

- A. Description of original monument and accessories and/or subsequent restoration:
  - 1839: G.L.O. Survey Lewis Clason set post & referenced: Cedar 18 N72½E 34, Fir 10 S54½W 19.
  - 1905: County Survey Jos. W. McNeil Piece of steel shafting 2" dia. flush with Road.
  - 1975: R.S. Scott Eng. Co. Robert Paquette set R.R. Spike & referenced.
  - 1986: Lewis Survey Earl T. Lewis Found R.R. Spike & referenced.
  - 1998: John F. Oliver Survey Found R.R. Spike.

- B. Description of corner evidence found and/or method applied in restoring or reestablishing corner:
  - 1999: Found R.R. Spike in centerline of E-W gravel rd. (Kitter Rd.) and 2' East of centerline of N-S gravel rd. (Carriveau Rd.). Found one existing Lewis witness: Roofing nail in Guy Pole S40E 48.40


The position of this corner is compatible with county and local surveys and is accepted as a careful and faithful perpetuation of the position of the original corner.

- C. Description of monument for corner and accessories established to perpetuate locating the position of the corner:
  - 1999: Removed R.R. Spike and replaced with 1/2" iron rod with 3" dia. alum. cap, stamped to identify the corner. Witnesses are:
    - Lewis roofing nail in Anchor Pole S40E 48.40
    - Road Sign Post S52W 42.00
    - Set tag P.S. #31591 in P. Pole N44E 41.81
    - Set tag P.S. #31591 in 8" Willow S75E 66.04

P.A. 345 ALPENA COUNTY  
PEER APPROVED 8/24/99

*[Signature]*

Signed by Thomas L. Fabis  
Surveyor's Michigan License No. 31591

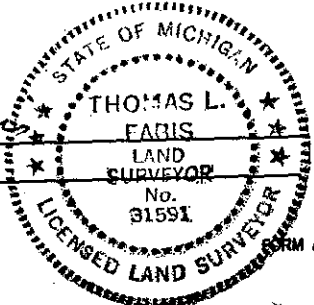

Date November 19, 1999