

JAN 21 2000

1999 ALPENA COUNTY REMONUMENTATION CORNER

SECTION

LAND CORNER RECORDATION CERTIFICATE
Filing Requirement of Act 74, Mich. P.A. 1970

For corners in

Alpena
(County)

Located in:

Corner Code #



L- 2 P- 237
11/22/1999 01:43P
Page: 1 of 1
Kathy J. Matash, Register Alpena Co., MI LDC 9.00

- 1. Public Land Survey T29N R8E E-11
 T R Sanborn Twp.
- 2. Property Controlling S T R _____
 in Section S T R _____
- 3. Miscellaneous S T R _____
 Property in Sec. S T R _____

Register of Deeds Stamp & File Number

- 4. Lot No. _____, Recorded Plat _____
- 5. Private Claims _____

	A	B	C	D	E	F	G	H	I	J	K	L	M
1													
2	6		5		4		3		2		1		
3													
4	7		8		9		10		11		12		
5													
6	18		17		16		15		14		13		
7													
8	19		20		21		22		23		24		
9													
10	30		29		28		27		26		25		
11													
12	31		32		33		34		35		36		
13													

I, Thomas L. Fabis, in a field survey on July 27, 1999 do hereby state that under requirements of P.A. 74, Michigan P.A. of 1970, the corner points mentioned in lines 1 and 2 above were in conformance with regulations and rules therefore as required in the current manual of survey instructions of the United States Department of the Interior, Bureau of Land Management or by a decree of a Court of Law and/or that the corner points mentioned in lines 3, 4 and 5 above were in conformance with the rules of the Michigan Board of Land Surveyors or by a Decree of a Court of Law; established, re-established, monumented, recovered, found as expressed below:

NOTE: Not more than 2 corners, all in the same town and range, may be recorded on this certificate.

- A. Description of original monument and accessories and/or subsequent restoration:
- 1839: G.L.O. Survey Lewis Clason Set post & referenced: Cedar 12 S61E 26, Do 24 N49W 17.
 - 1905: County Survey Jos. W. McNeil Found stake in center of road previously set by F.A. Rice.
 - 1976: R.S.Scot Engineering Co. Survey David B. Guthrie referenced corner.
 - 1987: Lewis Survey W.O. 4-387 Earl Lewis Found 1/2" Rod & referenced.


- B. Description of corner evidence found and/or method applied in restoring or reestablishing corner:
- 1999: Found 1/2" iron rod in centerline of Scott Rd. and 1' West of Carriveau Rd. centerline. Found two witnesses confirming that this is the same corner used by Lewis.

The position of this corner is compatible with county and local surveys and is accepted as a careful and faithful perpetuation of the position of the original corner.

- C. Description of monument for corner and accessories established to perpetuate locating the position of the corner:
- 1999: Set 3" dia. alum. cap, stamped to identify the corner, over the existing 1/2" iron rod. Set tag P.S. #31591 in the following witnesses:
 P. Pole N45W 42.15
 P. Pole S40W 56.17
 Fe. Post S53E 77.27
 6" R. Pine N45E 65.48

P.A. 345 ALPENA COUNTY
PEER APPROVED 8/24/99
D.P.B.

Signed by Thomas L. Fabis
Surveyor's Michigan License No. 31591

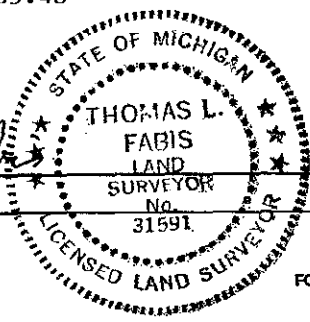

Date November 19, 1999