

JAN 21 2000

1999 ALPENA COUNTY REMONUMENTATION CORNER

LAND CORNER RECORDATION CERTIFICATE
Filing Requirement of Act 74, Mich. P.A. 1970

SECTION

For corners in

Alpena
(County)

Located In:

Corner Code #



L-2 P-236
11/22/1999 01:43P
Page: 1 of 1

Kathy J. Matash, Register Alpena Co., MI LDC 9.00

- 1. Public Land Survey T 29NR 8E E-12
 T ___ R ___ Sanborn Twp.
 T ___ R ___
 T ___ R ___
- 2. Property Controlling S ___ T ___ R ___
 in Section S ___ T ___ R ___
- 3. Miscellaneous S ___ T ___ R ___
 Property in Sec. S ___ T ___ R ___

- 4. Lot No. _____, Recorded Plat _____
- 5. Private Claims _____

Register of Deeds Stamp & File Number

	A	B	C	D	E	F	G	H	I	J	K	L	M
1													
2	6		5		4		3		2		1		
3													
4	7		8		9		10		11		12		
5													
6	18		17		16		15		14		13		
7													
8	19		20		21		22		23		24		
9													
10	30		29		28		27		26		25		
11													
12	31		32		33		34		35		36		
13													

I, Thomas L. Fabis, in a field survey on July 27, 1999 do hereby state that under requirements of P.A. 74, Michigan P.A. of 1970, the corner points mentioned in lines 1 and 2 above were in conformance with regulations and rules therefore as required in the current manual of survey instructions of the United States Department of the Interior, Bureau of Land Management or by a decree of a Court of Law and /or that the corner points mentioned in lines 3, 4 and 5 above were in conformance with the rules of the Michigan Board of Land Surveyors or by a Decree of a Court of Law; established, re-established, monumented, recovered, found as expressed below:

NOTE: Not more than 2 corners, all in the same town and range, may be recorded on this certificate.

- A. Description of original monument and accessories and/or subsequent restoration:
 - 1839: G.L.O. Survey Lewis Clason Set post & referenced: Hem 6 S44½E 26, S. Maple N18½W 11.
 - 1976: R.S. Scott Eng. Co. David B. Guthrie Set nail.
 - 1987: Lewis Survey Earl Lewis set 1/2" Rod & referenced.


- B. Description of corner evidence found and/or method applied in restoring or reestablishing corner:
 - 1999: Found 1/2" iron rod at intersection of old E-W fence lines and centerline of N-S gravel road (Carriveau Rd.). No existing witnesses.

The position of this corner is compatible with county and local surveys and is accepted as a careful and faithful perpetuation of the position of the original corner.

- C. Description of monument for corner and accessories established to perpetuate locating the position of the corner:
 - 1999: Set 3" dia. alum. cap, stamped to identify the corner, over the existing 1/2" iron rod. Set tag P.S. #31591 in the following reestablished witnesses:
 - 13" W. Pine S78W 47.91
 - 12" W. Pine S52W 65.24
 - Fe. Post N40E 37.59
 - New Cor. Fe. Post N84E 25.75

P.A. 345 ALPENA COUNTY
PEER APPROVED 8/26/99
D.P.A. [Signature]

Signed by Thomas L. Fabis
Surveyor's Michigan License No. 31591

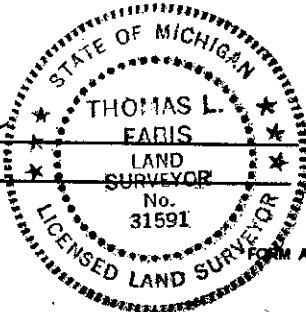

Date November 19, 1999