

JAN 21 2000

LAND CORNER RECORDATION CERTIFICATE  
Filing Requirement of Act 74, Mich. P.A. 1970

SECTION

For corners in

Alpena  
(County)

Located In:

Corner Code #



L- 2 P- 232  
11/22/1999 01:43P  
Page: 1 of 1  
Kathy J. Matash, Register Alpena Co., MI LDC 9.00

1. Public Land Survey

T29N R 8E  
T R  
T R  
T R

F-11  
Sanborn Twp.

2. Property Controlling in Section

S T R

3. Miscellaneous Property in Sec.

S T R

Register of Deeds Stamp & File Number

4. Lot No. \_\_\_\_\_, Recorded Plat \_\_\_\_\_

5. Private Claims \_\_\_\_\_

	A	B	C	D	E	F	G	H	I	J	K	L	M
1													
2	6		5		4		3		2		1		
3													
4	7		8		9		10		11		12		
5													
6	18		17		16		15		14		13		
7													
8	19		20		21		22		23		24		
9													
10	30		29		28		27		26		25		
11													
12	31		32		33		34		35		36		
13													

I, Thomas L. Fabis, in a field survey on June 15, 1999 do hereby state that under requirements of P.A. 74, Michigan P.A. of 1970, the corner points mentioned in lines 1 and 2 above were in conformance with regulations and rules therefore as required in the current manual of survey instructions of the United States Department of the Interior, Bureau of Land Management or by a decree of a Court of Law and /or that the corner points mentioned in lines 3, 4 and 5 above were in conformance with the rules of the Michigan Board of Land Surveyors or by a Decree of a Court of Law, established, re-established, monumented, recovered, found as expressed below:

NOTE: Not more than 2 corners, all in the same town and range, may be recorded on this certificate.

A. Description of original monument and accessories and/or subsequent restoration:

- 1839: G.L.O. Survey Lewis Clason set post & referenced: W. Wood 12 N17½W 38, Cedar 10 S42E 06.
- 1975: R.S. Scott Eng. Co. Survey Robert Paquette found iron & referenced.
- 1999: Alpena Co. Rd. Comm. Notes Gary St. Charles found 1/2" rerod & referenced.

B. Description of corner evidence found and/or method applied in restoring or reestablishing corner:

- 1999: Found 1/2" iron rod 7' North of E-W gravel road (Scott Rd.) and 2' West of N-S gravel road (Behning Rd.). Also found 2 witnesses confirming that this is the same corner position used by Paquette and St. Charles.

The position of this corner is accepted as a careful and faithful perpetuation of the position of the original corner.

C. Description of monument for corner and accessories established to perpetuate locating the position of the corner:


- 1999: Set 3" dia. alum. cap, stamped to identify the corner, over the existing 1/2" iron rod. Witnesses are:  
Tag #41922 in P. Pole N40W 43.96  
Tag #41922 in P. Pole Stub N44E 42.05  
Stop Sign Post N80E 65.26  
Stop Sign Post S77W 81.25

P.A. 345 ALPENA COUNTY  
PEER APPROVED 8/26/99  
*Oil B. Covert*

Signed by

*Thomas L. Fabis*

Surveyor's Michigan License No. 31591

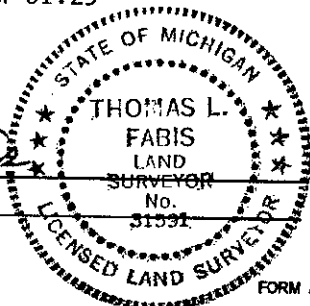

Date November 19, 1999