

JAN 21 2000

1999 ALPENA COUNTY REMONUMENTATION CORNER

LAND CORNER RECORDATION CERTIFICATE
Filing Requirement of Act 74, Mich. P.A. 1970

SECTION

For corners in

Alpena
(County)

Located in:

Corner Code #



L- 2 P- 241
11/22/1999 01:43P
Page: 1 of 1
Kathy J. Matash, Register Alpena Co., MI LDC 9.00

- 1. Public Land Survey T 29 R 8E I-10
 T ___ R ___ Sanborn Twp.
- 2. Property Controlling S ___ T ___ R ___
 in Section S ___ T ___ R ___
- 3. Miscellaneous S ___ T ___ R ___
 Property in Sec. S ___ T ___ R ___

Register of Deeds Stamp & File Number

- 4. Lot No. _____, Recorded Plat _____
- 5. Private Claims _____

I, Thomas L. Fabis, in a field survey on June 15, 1999 do hereby state that under requirements of P.A. 74, Michigan P.A. of 1970, the corner points mentioned in lines 1 and 2 above were in conformance with regulations and rules therefore as required in the current manual of survey instructions of the United States Department of the Interior, Bureau of Land Management or by a decree of a Court of Law and/or that the corner points mentioned in lines 3, 4 and 5 above were in conformance with the rules of the Michigan Board of Land Surveyors or by a Decree of a Court of Law; established, re-established, monumented, recovered, found as expressed below:

NOTE: Not more than 2 corners, all in the same town and range, may be recorded on this certificate.

	A	B	C	D	E	F	G	H	I	J	K	L	M
1													
2	6	5	4	3	2	1							
3													
4	7	8	9	10	11	12							
5													
6	18	17	16	15	14	13							
7													
8	19	20	21	22	23	24							
9													
10	30	29	28	27	26	25							
11													
12	31	32	33	34	35	36							
13													

A. Description of original monument and accessories and/or subsequent restoration:

- 1839: G.L.O. Survey Lewis Clason set post & referenced: Hem 16 S73E 17, Do 12 N34W 50.
- 1902: County Survey Jos. W. McNeil set stake.
- 1903: County Survey Jos. W. McNeil revisits corner.
- 1995: Survey Liber 2 Page 921 Thomas Fabis found R.R. Spike & referenced.
- 1997: Lewis Field Notes W.O. 0403045S Wayne Lewis found R.R. Spike & referenced.

B. Description of corner evidence found and/or method applied in restoring or reestablishing corner:

- 1999: Found R.R. Spike at East edge of gravel rd. (Pratt Rd.). Found 3 witnesses confirming that this is the same corner used by Lewis and Fabis.

The position of this corner is compatible with county and local surveys and is accepted as a careful and faithful perpetuation of the position of the original corner.

C. Description of monument for corner and accessories established to perpetuate locating the position of the corner:

- 1999: Removed R.R. Spike and replaced it with a 1/2" iron rod with a 3" dia. alum. cap, stamped to identify the corner. Witnesses are:
 - Tag #31591 in 9" Birch S25E 65.53
 - Tag #31591 in 12" Birch N84W 49.95
 - Tag #31591 in 13" R. Pine N40E 71.42
 - Tag #41922 in P. Pole N44W 50.27


P.A. 345 ALPENA COUNTY
PEER APPROVED 8/26/99

[Signature]

Signed by

Thomas L. Fabis

Surveyor's Michigan License No. 31591

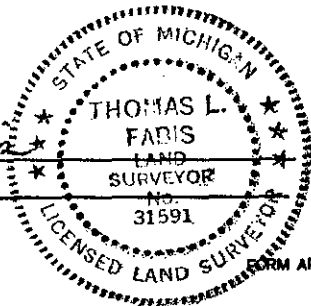

Date November 19, 1999