

1999 ALPENA COUNTY REMONUMENTATION CORNER

LAND CORNER RECORDATION CERTIFICATE

Filing Requirement of Act 74, Mich. P.A. 1970

REGISTERED

JAN 21 2000

SECTION

For corners in

Alpena (County)	Located In:	Corner Code ##
1. Public Land Survey	T 29N R 8E	I-11
	T _____ R _____	Sanborn Twp.
	T _____ R _____	
	T _____ R _____	
2. Property Controlling in Section	S _____ T _____ R _____	
	S _____ T _____ R _____	
3. Miscellaneous Property in Sec.	S _____ T _____ R _____	
	S _____ T _____ R _____	

Register of Deeds Stamp & File Number

4. Lot No. _____, Recorded Plat _____
5. Private Claims _____

	A	B	C	D	E	F	G	H	I	J	K	L	M
2	6	5	4	3	2	1							
3													
4	7	8	9	10	11	12							
5													
6	18	17	16	15	14	13							
7													
8	19	20	21	22	23	24							
9													
10	30	29	28	27	26	25							
11													
12	31	32	33	34	35	36							
13													

I, Thomas L. Fabis, in a field survey on June 15, 1999, do hereby certify that under requirements of P.A. 74, Michigan P.A. of 1970, the corner points mentioned in lines 1 and 2 above were in conformance with regulations and rules therefore as required in the current manual of survey instructions of the United States Department of the Interior, Bureau of Land Management or by a decree of a Court of Law and/or that the corner points mentioned in lines 3, 4 and 5 above were in conformance with the rules of the Michigan Board of Land Surveyors or by a Decree of a Court of Law; established, re-established, monumented, re-monumented, recovered, found as expressed below:

NOTE: Not more than 4 corners, all in the same town and range, may be recorded on this certificate.

A. Description of original monument and accessories and/or subsequent restoration:

- 1839: G.L.O. Survey Lewis Clason set post & referenced: S. Maple 12 N42 1/2 W 36, Fir 9 S62E 26.
- 1902 & 1906: County Surveys Jos. W. McNeil old stake in center of crossroads.
- 1972 & 1974: R.S.Scott Eng. Co. Surveys & L.C.R.C. set R.R. Spike & referenced.
- 1981, 1987 & 1994: R.S. Scott Surveys David Guthrie Set 1/2" iron & referenced.
- 1995: Section Breakdown Notes Thomas Fabis 1/2" iron.
- 1997: Alpha Land Survey Co. David Guthrie Existing 1/2" iron & referenced.
- 1998: Wilcox Field Notes W.O. 98692 Found 3/8" Rebar.

B. Description of corner evidence found and/or method applied in restoring or reestablishing corner:

1999: Found 1/2" iron rod & 5 existing witnesses as listed below in Part C.

The position of this corner is compatible with county and local surveys and is accepted as a careful and faithful perpetuation of the position of the original corner.



L- 2 P- 229
11/22/1999 01:43P
Page: 1 of 1
Kathy J. Matash, Register Alpena Co., MI LDC 9.00


C. Description of monument for corner and accessories established to perpetuate locating the position of the corner:

- 1999: Set 3" dia. alum. cap, stamped to identify the corner over the existing 1/2" iron rod. Witnesses are:
 - Tag #22435 in 6" Birch S63E 72.72
 - Tag #31591 in P. Pole N40W 48.15
 - Tag #31591 in Tele. Pole S49W 43.93
 - Tag #31591 in 22" Maple S40E 44.58
 - Tag #31591 in 6" Birch S67E 73.55

P.A. 345 ALPENA COUNTY
PEER APPROVED 8/24/99

D.P.B.

Signed by Thomas L. Fabis

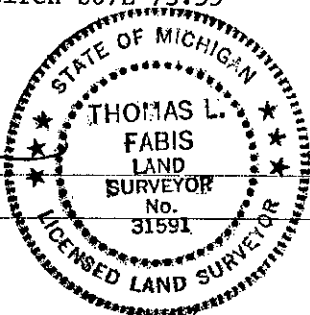

Date November 19, 1999

Surveyor's Michigan License No. 31591