

1999 ALPENA COUNTY REMONUMENTATION CORNER

LAND CORNER RECORDATION CERTIFICATE
Filing Requirement of Act 74, Mich. P.A. 1970

RE...

For corners in Alpena (County) Located In: _____ Corner Code # _____

1. Public Land Survey T 29N R 8E J-11
T _____ R _____ Sanborn Twp.
T _____ R _____
T _____ R _____

2. Property Controlling S _____ T _____ R _____
in Section S _____ T _____ R _____

3. Miscellaneous S _____ T _____ R _____
Property in Section S _____ T _____ R _____

4. Lot No. _____, Recorded Plat _____

5. Private Claims _____

JAN 21 2000

SECTION

Register of Deeds Stamp & File Number

A	B	C	D	E	F	G	H	I	J	K	L	M
2	6	5	4	3	2	1						
3												
4	7	8	9	10	11	12						
5												
6	18	17	16	15	14	13						
7												
8	19	20	21	22	23	24						
9												
10	30	29	28	27	26	25						
11												
12	31	32	33	34	35	36						
13												

I, Thomas L. Fabis, in a field survey on July 27, 19 99, do hereby certify that under requirements of P.A. 74, Michigan P.A. of 1970, the corner points mentioned in lines 1 and 2 above were in conformance with regulations and rules therefore as required in the current manual of survey instructions of the United States Department of the Interior, Bureau of Land Management or by a decree of a Court of Law and/or that the corner points mentioned in lines 3, 4 and 5 above were in conformance with the rules of the Michigan Board of Professional Surveyors or by a Decree of a Court of Law; established, re-established, monumented, re-monumented, recovered, found as expressed below:

NOTE: Not more than 4 corners, all in the same town and range, may be recorded on this certificate.

A. Description of original monument and accessories and/or subsequent restoration:

- 1839: G.L.O. Survey Lewis Clason set post & referenced: B. Oak 12 N44 1/2 W 17, Y. Pine 16 S77E 36.
- 1906: County Survey J. W. McNeil set 1/4 stake.
- 1970's: M.D.O.T. R.O.W. Maps 1 1/4" Gas Pipe & referenced.
- 1972 thru 1974: Surveys & L.C.R.C. R.S.Scott Eng. Co. existing steel bar & referenced.
- 1980 & 1983: David Guthrie Surveys existing 1" iron rod & referenced.
- 1983 & 1988: Earl Lewis Surveys existing 5/8" square steel rod & referenced.
- 1987 & 1994: David Guthrie Surveys 3/4" Iron Bar & referenced.
- 1995: Thomas Fabis Section Breakdown Notes 3/4" iron.
- 1997: Lewis & Lewis Witness Notes found 1" Pin and raised with rod & cap and referenced.

B. Description of corner evidence found and/or method applied in restoring or reestablishing corner:

- 1999: Found 1/2" iron rod with red cap P.S. #41922 and found 4 existing witnesses confirming location of corner.

The position of this corner is compatible with county and local surveys and is accepted as a careful and faithful perpetuation of the position of the original corner.



L- 2 P- 230
11/22/1999 01:43P
Page: 1 of 1

Kathy J. Matash, Register Alpena Co., MI LDC 9.00


P.A. 345 ALPENA COUNTY
PEER APPROVED 8/26/99

D.J.B. [Signature]

C. Description of monument for corner and accessories established to perpetuate locating the position of the corner:

- 1999: Removed existing red cap and set 3" dia. alum. cap, stamped to identify the corner over the existing 1/2" iron rod. Witnesses are:
Tag #31591 in P. Pole N45W 45.80
Tag #22435 in 19" Maple South 25.13
Roofing Nail in Pine N6E 30.27
Roofing Nail in 24" Oak S2E 31.11

Signed by Thomas L. Fabis
Surveyor's Michigan License No. 31591

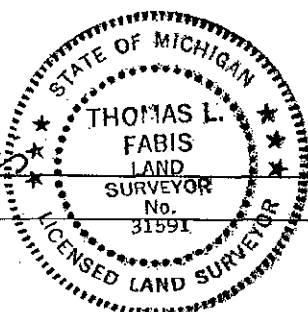

Date November 19, 1999