LEER 1 PACE 215
LAND CORNER RECORDATION CERTIFICATE

Filing Requirement of Act 74, Mich. P.A. 1970

RECORDED ALPENA COUNTY, MI.

For corners in

| | Al pena (County) | Located In: | Corner Code ≠# |
|----|---------------------------------|--|----------------------------|
| 1. | Public Land Survey | T 29 R 9E T 29 R 9E T 29 R 9E T 29 R 9E | D-9 E-9 E-10 E-11 |
| 2 | Property Controlling in Section | S T R S T R | |
| 3 | Miscellaneous Property in Sec | S T B | |

Aug 14 2 16 PM '90


Caroles bommerfeld REGISTER OF DEEDS


Register of Deeds Stamp & File Number

- 4. Lot No. _____, Recorded Plat
- 5. Private Claims

I. Daniel Schnipsema in a lield survey on September 22 19 88 ob hereby certify that under requirements of P.A. 74, Michigan P.A. of 1970, the corner points mentioned in lines 1 and 2 above were in conformance with regulations and rules therefore as required in the current manual of survey instructions of the United States Department of the Interior, Bureau of Land Management or by a decree of a Court of Law and/or that the corner points mentioned in lines 3, 4 and 5 above were in conformance with the rules of the Michigan Board of Land Surveyors or by a Decree of a Court of Law, established, re-established, monumented, re-monumented, recovered, found as expressed below.

NOTE: Not more than 4 corners, all in the same town and range, may be recorded on this certificate.

 

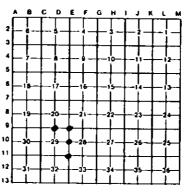

- B. Description of corner evidence found and/or method applied in restoring or reestablishing corner:
 - D-9 1/4 Corner Common to Section 20 & 29 Set 1/2" ReRod/Cap @ Fence Corner & Wooden Stake
 - E-9 Corner Common to Sections 20, 21, 28 & 29 Set 1/2" ReRod/Cap, Set by dbl. prop.
 - E-10 1/4 Corner Common to Sections 28 & 29 Set 1/2" ReRod/Cap Single Proration
 - E-11 Corner Common to Sections 28, 29, 32 & 33
 Found stake remains @ 250' (+/-) West of Railroad which is in agreement with 1907
 Survey of Record Set 1/2" ReRod/Cap
- C Description of monument for corner and accessories established to perpetuate locating the position of the corner

E-11 - 1/2" ReRod/Cap

N 80 W 12" W. Birch 4.89 N 10 E 6" W. Birch 15.74 West 5" Fir 14.27 S 85 E 5" W. Birch 14.50

Signed by

Liches No. #2461

Date 5-23-90

FORM APPROVED BY MICHMAN STATE BOARD OF LAND SURVEYORS, JAN. 20, 1871 REVISED MAY 14, 1875