

LAND CORNER RECORDATION CERTIFICATE
Filing Requirement of Act 74, Mich. P.A. 1970

For corners in

ALPENA COUNTY <small>County</small>	Located In:	Corner Code //
1 Public Land Survey	T R	
	T R	
	T R	
	T R	
2 Property Controlling in Section	S 18 T 29N R 9E	A-6,8
	S T R	
3 Miscellaneous Property in Sec	S T R	
	S T R	
4 Lot No	Recorded Plat	
5 Private Claims		

Register of Deeds Stamp & File Number

	A	B	C	D	E	F	G	H	I	J	K	L	M
2	6	5	4	3	2	1							
3													
4	7	8	9	10	11	12							
5													
6	18	17	16	15	14	13							
7													
8	19	20	21	22	23	24							
9													
10	30	29	28	27	26	25							
11													
12	31	32	33	34	35	36							
13													

I, **Carl R. Johnson**, in a field survey on **March 7**, 19**86**, do hereby certify that under requirements of P.A. 74, Michigan P.A. of 1970, the corner points mentioned in lines 1 and 2 above were in conformance with regulations and rules therefore as required in the current manual of survey instructions of the United States Department of the Interior, Bureau of Land Management or by a decree of a Court of Law and/or that the corner points mentioned in lines 3, 4 and 5 above were in conformance with the rules of the Michigan Board of Land Surveyors or by a Decree of a Court of Law, established, re-established, monumented, re-monumented, recovered, found as expressed below.

NOTE: Not more than 4 corners, all in the same town and range, may be recorded on this certificate.

A Description of original monument and accessories and/or subsequent restoration:

B Description of corner evidence found and/or method applied in restoring or reestablishing corner.


A-6,8 - Set SE corner of Gov't Lot 1, Section 18 at the calculated G.L.O. meander line, on FW $\frac{1}{4}$ line.

C Description of monument for corner and accessories established to perpetuate locating the position of the corner.

A-6, 8

Set 5/8" Rod w/RLS cap
 5" White Ash S35°E 6.6'
 4" White Ash S35°W 6.9'

Signed by *Carl R. Johnson*
 Surveyor's Michigan License No.

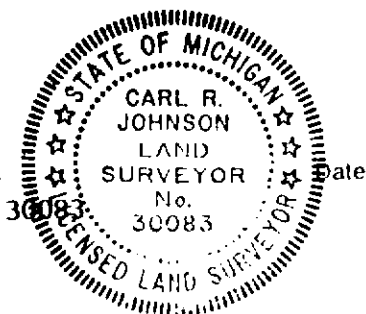

6/5/86