

**SURVEY & REMONUMENTATION**

FEB 03 1998

1997 ALPENA COUNTY REMONUMENTATION CORNER

**LAND CORNER RECORDATION CERTIFICATE**

Filing Requirement of Act 74, Mich. P.A. 1970

**SECTION**

For corners in Alpena (County) Located In: Corner Code #

1. Public Land Survey T 30N R 5E J-9 (S $\frac{1}{4}$ , 23)  
 T \_\_\_\_\_ R \_\_\_\_\_ Green Twp.  
 T \_\_\_\_\_ R \_\_\_\_\_  
 T \_\_\_\_\_ R \_\_\_\_\_

2. Property Controlling in Section S \_\_\_\_\_ T \_\_\_\_\_ R \_\_\_\_\_  
 S \_\_\_\_\_ T \_\_\_\_\_ R \_\_\_\_\_

3. Miscellaneous Property in Section S \_\_\_\_\_ T \_\_\_\_\_ R \_\_\_\_\_  
 S \_\_\_\_\_ T \_\_\_\_\_ R \_\_\_\_\_

4. Lot No. \_\_\_\_\_, Recorded Plat \_\_\_\_\_

5. Private Claims \_\_\_\_\_

Liber 00002 Page 0080  
 STATE OF MICHIGAN  
 County of Alpena  
 Recorded  
 08-06-1997 10:44:56  
 Kathy J. Matash  
 REGISTER OF DEEDS

Register of Deeds Stamp & File Number

A	B	C	D	E	F	G	H	I	J	K	L	M
2	6	5	4	3	2	1						
3												
4	7	8	9	10	11	12						
5												
6	18	17	16	15	14	13						
7												
8	19	20	21	22	23	24						
9												
10	30	29	28	27	26	25						
11												
12	31	32	33	34	35	36						
13												

I, Thomas L. Fabis, in a field survey on May 18, 1997, do hereby certify that under requirements of P.A. 74, Michigan P.A. of 1970, the corner points mentioned in lines 1 and 2 above were in conformance with regulations and rules therefore as required in the current manual of survey instructions of the United States Department of the Interior, Bureau of Land Management or by a decree of a Court of Law and/or that the corner points mentioned in lines 3, 4 and 5 above were in conformance with the rules of the Michigan Board of Professional Surveyors or by a Decree of a Court of Law; established, re-established, monumented, re-monumented, recovered, found as expressed below:

NOTE: Not more than 4 corners, all in the same town and range, may be recorded on this certificate.

**A. Description of original monument and accessories and/or subsequent restoration:**

- 1840: G.L.O. Survey by Lewis Clason - Set post & referenced: (Y. Pine 22 S43W 60, Beech 8 N60E 60).
- 1911: County Survey by Jos. McNeil - Set 1/4 S. and referenced.
- 1912: County Survey by Wm. LeRoy - Cedar stake 3" sq. in Road & referenced.
- 1932: County Survey by Wm. LeRoy - Replaced old stake with concrete 4" x 4" x 30".
- 1975: Survey by Robert Paquette of R.S. Scott Engineering Co. (W.O. 4-5039) - Found iron & referenced.

**B. Description of corner evidence found and/or method applied in restoring or reestablishing corner:**


- 1997: Found 1/2" iron rod 3' North of centerline of Spratt Rd (gravel surface). Found property iron 33' North and one witness: concrete fence post - N30W - 38.45' which matches the Robert Paquette Survey of 1975.

The position of this corner is compatible with county and local surveys and is accepted as a careful and faithful perpetuation of the position of the original corner.

P.A. 345 ALPENA COUNTY  
 PEER APPROVED 6/19/97  
*D.J.B. [Signature]*

**C. Description of monument for corner and accessories established to perpetuate locating the position of the corner:**

- 1997: Set 3" dia. aluminum cap, stamped to identify the corner, over the existing 1/2" iron rod.  
 Reestablished witnesses are:  
 Centerline of Concrete Fence Post - N30W - 38.45'  
 Tag #41922 in 6" Aspen - N2E - 54.16'  
 Tag #41922 in P. Pole - S30W - 41.51'  
 Centerline of Steel Fe. Cor. - S8E - 38.70'

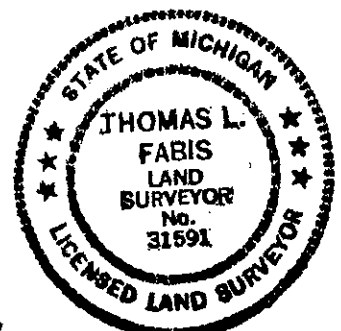

Signed by Thomas L. Fabis

Date July 31, 1997

Surveyor's Michigan License No. 31591