

# SURVEY & REMONUMENTATION

FEB 03 1998

1997 ALPENA COUNTY REMONUMENTATION CORNER

## LAND CORNER RECORDATION CERTIFICATE

Filing Requirement of Act 74, Mich. P.A. 1970

### SECTION

For corners in

Alpena  
(County)

Located In:

Corner Code #

Liber **00002** Page **0079**

STATE OF MICHIGAN  
County of Alpena  
Recorded  
08-06-1997 10:44:46  
Kathy J. Matash  
REGISTER OF DEEDS

1. Public Land Survey	T	<u>30N</u>	R	<u>5E</u>	<u>K-9 (SW, 24)</u>
	T	_____	R	_____	<u>Green Twp.</u>
	T	_____	R	_____	_____
	T	_____	R	_____	_____
2. Property Controlling in Section	S	_____	T	_____	_____
	S	_____	T	_____	_____
3. Miscellaneous	S	_____	T	_____	_____
Property in Section	S	_____	T	_____	_____

Register of Deeds Stamp & File Number

4. Lot No. \_\_\_\_\_, Recorded Plat \_\_\_\_\_

5. Private Claims \_\_\_\_\_

	A	B	C	D	E	F	G	H	I	J	K	L	M
2	6		5		4		3		2		1		
3													
4	7		8		9		10		11		12		
5													
6	18		17		16		15		14		13		
7													
8	19		20		21		22		23		24		
9													
10	30		29		28		27		26		25		
11													
12	31		32		33		34		35		36		
13													

I, Thomas L. Fabis, in a field survey on May 18, 1997, do hereby certify that under requirements of P.A. 74, Michigan P.A. of 1970, the corner points mentioned in lines 1 and 2 above were in conformance with regulations and rules therefore as required in the current manual of survey instructions of the United States Department of the Interior, Bureau of Land Management or by a decree of a Court of Law and/or that the corner points mentioned in lines 3, 4 and 5 above were in conformance with the rules of the Michigan Board of Professional Surveyors or by a Decree of a Court of Law; established, re-established, monumented, re-monumented, recovered, found as expressed below:

**NOTE: Not more than 4 corners, all in the same town and range, may be recorded on this certificate.**

**A. Description of original monument and accessories and/or subsequent restoration:**

- 1840: G.L.O. Survey by Lewis Clason - Set post & referenced: (Beech 22 N21W 66, Do 14 S19E 55).
- 1888 & 1893: County Surveys by Fred A. Rice - Visited corner.
- 1911: County Survey by Jos. McNeil - Dug up old stake and set new one.
- 1993: Survey Notes by Dan Kibbe of Wilcox & Associates - Found 1/2" Bar.

**B. Description of corner evidence found and/or method applied in restoring or reestablishing corner:**

- 1997: Found 1/2" Bar 3' North of centerline of Spratt Rd. (gravel surface).

The position of this corner is compatible with county and local surveys and is accepted as a careful and faithful perpetuation of the position of the original corner.


P.A. 345 ALPENA COUNTY  
PEER APPROVED 7/19/97  
*D. B. [Signature]*

**C. Description of monument for corner and accessories established to perpetuate locating the position of the corner:**

- 1997: Set 3" dia. aluminum cap, stamped to identify the corner, over a 1/2" iron rod and in place of the existing 1/2" Bar.

Tags P.S. #41922 are in the following reestablished witnesses:  
 Cor. Fe. Post - North - 41.16'  
 Cor. Fe. Post - South - 35.58'  
 24" Elm - N60W - 81.21'  
 24" Maple - S76W - 100.45'

Signed by Thomas L. Fabis

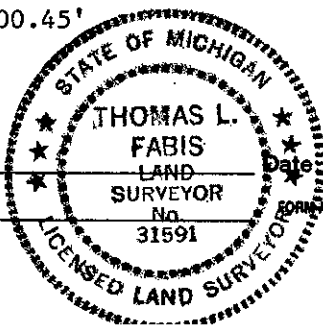

Date: July 31, 1997

Surveyor's Michigan License No. 31591