

**1999 Alpena County Remonumentation Corner  
LAND CORNER RECORDATION CERTIFICATE  
Filing Requirement of Act 74, Mich. P.A. 1970**

RECORDED

JAN 21 2000

For corners in

<u>Alpena</u> (County)	Located In:	Corner Code #
1. Public Land Survey	T <u>30N</u> R <u>5E</u>	<u>K-13</u>
	T _____ R _____	
	T _____ R _____	
	T _____ R _____	
2. Property Controlling in Section	S _____ T _____ R _____	
	S _____ T _____ R _____	
3. Miscellaneous Property in Sec.	S _____ T _____ R _____	
	S _____ T _____ R _____	

SECTION



**L-2 P-281**  
12/10/1999 01:39P  
Page: 1 of 1  
Kathy J. Matash, Register Alpena Co., MI LDC 9.00

Register of Deeds Stamp & File Number

4. Lot No. \_\_\_\_\_, Recorded Plat \_\_\_\_\_  
5. Private Claims \_\_\_\_\_

I, Daniel T. Kibbe, in a field survey on June 14, 1999 do hereby state that under requirements of P.A. 74, Michigan P.A. of 1970, the corner points mentioned in lines 1 and 2 above were in conformance with regulations and rules therefore as required in the current manual of survey instructions of the United States Department of the Interior, Bureau of Land Management or by a decree of a Court of Law and /or that the corner points mentioned in lines 3, 4 and 5 above were in conformance with the rules of the Michigan Board of Land Surveyors or by a Decree of a Court of Law; established, re-established, monumented, recovered, found as expressed below:

A	B	C	D	E	F	G	H	I	J	K	L	M
1												
2	6		5		4		3		2		1	
3												
4	7		8		9		10		11		12	
5												
6	18		17		16		15		14		13	
7												
8	19		20		21		22		23		24	
9												
10	30		29		28		27		26		25	
11												
12	31		32		33		34		35		36	
13												

**NOTE: Not more than 2 corners, all in the same town and range, may be recorded on this certificate**

A. Description of original monument and accessories and/or subsequent restoration:

- 1839: GLO Survey by Lewis Clason: Set post. Referenced: Hemlock 14-N44E-17/ Hard Maple 15-N14W-46.
- 1964: Plat of West View James L. Scott. Referenced corner.
- 1980: Survey by Duane R. MacNeill. Referenced corner.
- 1983: Survey by Duane R. MacNeill. Referenced corner.
- 1983: Survey by Duane R. MacNeill. Referenced corner.
- 1986: Survey by Duane R. MacNeill. Referenced corner.
- 1987: Survey by Duane R. MacNeill. Referenced corner.
- 1997: Survey notes by Thomas L. Fabis. Pipe in mon. box.

B. Description of corner evidence found and/or method applied in restoring or reestablishing corner:

1999: Remon. Survey by Daniel T. Kibbe. Found 3/4" pipe in Monument Box, 33' North of CL Beaver Lake Road, 15' East of CL O'Hurn.

This corner position is compatible with county & local surveys. This corner position is accepted as a careful and faithful perpetuation of the position of the original corner.

C. Description of monument for corner and accessories established to perpetuate locating the position of the corner:


1999: Placed 3" Alpena County cap stamped to identify the corner over 1/2" iron rod in monument box.

Referenced:

- P. Pole-set tag-S26E 78.29'
- Anchor Pole-set tag-S35 W 84.35'
- P. Pole-set tag-N88 W 70.43'
- Remon. corner K-1 East - 7.92'

P.A. 345 ALPENA COUNTY  
PEER APPROVED 9/14/99  
*D. P. [Signature]*

Signed by \_\_\_\_\_  
Surveyor's Michigan License No. 37278

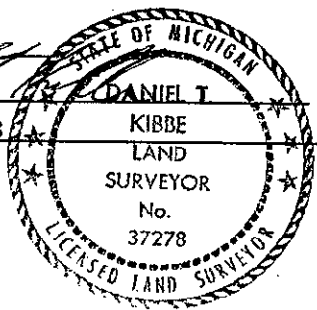

Date November 30, 1999