

**1999 Alpena County Remonumentation Corner
LAND CORNER RECORDATION CERTIFICATE
Filing Requirement of Act 74, Mich. P.A. 1970**

RECORDED

JAN 21 2000

For corners in

Alpena
(County)

Located In:

Corner Code #

SECTION

1. Public Land Survey

T 30N R 5E

L-13

T ___ R ___

T ___ R ___

T ___ R ___

2. Property Controlling
in Section

S ___ T ___ R ___

S ___ T ___ R ___

3. Miscellaneous
Property in Sec.

S ___ T ___ R ___

S ___ T ___ R ___



L- 2 P- 282

12/10/1999 01:39P

Page: 1 of 1

Kathy J. Matash, Register Alpena Co., MI LDC 9.00

Register of Deeds Stamp & File Number

4. Lot No. _____, Recorded Plat _____
5. Private Claims _____

A	B	C	D	E	F	G	H	I	J	K	L	M
1												
2	6	5	4	3	2	1						
3												
4	7	8	9	10	11	12						
5												
6	18	17	16	15	14	13						
7												
8	19	20	21	22	23	24						
9												
10	30	29	28	27	26	25						
11												
12	31	32	33	34	35	36						
13												

I, Daniel T. Kibbe, in a field survey on June 14, 1999 do hereby state that under requirements of P.A. 74, Michigan P.A. of 1970, the corner points mentioned in lines 1 and 2 above were in conformance with regulations and rules therefore as required in the current manual of survey instructions of the United States Department of the Interior, Bureau of Land Management or by a decree of a Court of Law and /or that the corner points mentioned in lines 3, 4 and 5 above were in conformance with the rules of the Michigan Board of Land Surveyors or by a Decree of a Court of Law; established, re-established, monumented, recovered, found as expressed below:

NOTE: Not more than 2 corners, all in the same town and range, may be recorded on this certificate

A. Description of original monument and accessories and/or subsequent restoration:

- 1839: GLO Survey by Lewis Clason. Set 1/4 post. Referenced: Hard Maple 13-N47E-25/Beech 7 - N20W 42
- 1997: Survey by Thomas L. Fabis. Set 1/2" iron rod North side fence post. Referenced: 18" Oak-N50W-11.97/14" Twin Maple-N10E-12.47/ 6" Twin Maple-N80W-11.27/Power pole-S35E-75.07.

B. Description of corner evidence found and/or method applied in restoring or reestablishing corner:

- 1999: Remon. Survey by Daniel T. Kibbe. Found Fabis Bar & Cap wedged into North side of large fence post, on fence line to North and 33' North of CL Beaver Lake Road.


This corner position is compatible with county & local surveys. This corner position is accepted as a careful and faithful perpetuation of the position of the original corner.

C. Description of monument for corner and accessories established to perpetuate locating the position of the corner:

- 1999: Placed 3" Alpena County cap stamped to identify the corner over 1/2" iron rod.
Referenced:
26" Oak-found Fabis tag-N45 W 11.97'
26" Twin Oak-found Fabis tag-North 12.63'
7" Tri. Maple-found Fabis tag-N83 W 11.36'
Set spike N. edge of bit. S63E 51.04'
Remon. corner L-1 T29N R5E-East 3.96'

P.A. 345 ALPENA COUNTY
PEER APPROVED 9/16/99
D.P.B. [Signature]

Signed by *[Signature]*
Surveyor's Michigan License No. 37278

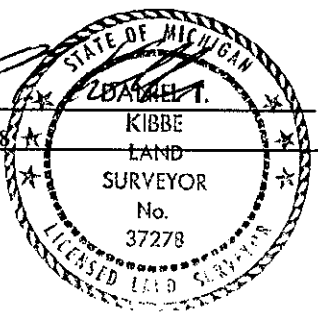

Date November 30, 1999