

SURVEY & REMONUMENTATION

FEB 03 1998 1997 ALPENA COUNTY REMONUMENTATION CORNER

LAND CORNER RECORDATION CERTIFICATE

Filing Requirement of Act 74, Mich. P.A. 1970

Liber 00002 Page 0083

SECTION

For corners in

Alpena
(County)

Located In:

Corner Code #

1. Public Land Survey

T 30N R 5E

M-5, (SE, 12)

T _____ R _____

Green Twp.

T _____ R _____

T 30N R 6E

A-5, (SW, 7)

S _____ T _____ R _____

Green Twp.

S _____ T _____ R _____

S _____ T _____ R _____

S _____ T _____ R _____

2. Property Controlling in Section

3. Miscellaneous

Property in Section

4. Lot No. _____, Recorded Plat _____

5. Private Claims _____

STATE OF MICHIGAN
County of Alpena
Recorded
08-06-1997 10:45:28
Kathy J. Matash
REGISTER OF DEEDS

Register of Deeds Stamp & File Number

	A	B	C	D	E	F	G	H	I	J	K	L	M
2	6		5		4		3		2		1		
3													
4	7		6		5		4		3		2		1
5													
6	18		17		16		15		14		13		
7													
8	19		20		21		22		23		24		
9													
10	30		29		28		27		26		25		
11													
12	31		32		33		34		35		36		
13													

I, Thomas L. Fabis, in a field survey on May 12, 1997, do hereby certify that under requirements of P.A. 74, Michigan P.A. of 1970, the corner points mentioned in lines 1 and 2 above were in conformance with regulations and rules therefore as required in the current manual of survey instructions of the United States Department of the Interior, Bureau of Land Management or by a decree of a Court of Law and/or that the corner points mentioned in lines 3, 4 and 5 above were in conformance with the rules of the Michigan Board of Professional Surveyors or by a Decree of a Court of Law; established, re-established, monumented, re-monumented, recovered, found as expressed below:

NOTE: Not more than 4 corners, all in the same town and range, may be recorded on this certificate.

A. Description of original monument and accessories and/or subsequent restoration:

- 1840: G.L.O. Survey Lewis Clason-Set Post & referenced: (Hd. Maple 12 S21W 33, Beech 8' N65W 47)
- 1907: County Survey Jos. McNeil - Corner in range line road.
- 1922 & 1929: County Survey Wm. LeRoy - 2" Galv. Pipe.
- 1974: L.C.R.C. Liber 1 Page 47 Delmer Porter - Found 2" Pipe & referenced.
- 1988: County Rd. Comm. Survey Records Gary St. Charles - 1/2" Pipe & referenced.
- 1993: Survey W.O. 4-1779 Earl Lewis - Exis. Monument Box & referenced.
- 1994: Survey Notes Farrier Surveying - 1/2" iron & cap in Mon. Box.
- 1996: Survey Notes Dan Kibbe Wilcox & Assoc. - Found B & C in Mon. Box.

B. Description of corner evidence found and/or method applied in restoring or reestablishing corner:


- 1997: Found 1/2" iron rod with unknown cap in Mon. Box. Found 1/2" iron rod property corner capped P.S. #15410 33' Due North of corner. Also found three existing witnesses indicating this is the same corner position used by the surveyors mentioned above.

P.A. 345 ALPENA COUNTY
PEER APPROVED 6/19/97
D. B. L...

The position of this corner is accepted as a careful and faithful perpetuation of the position of the original corner.

C. Description of monument for corner and accessories established to perpetuate locating the position of the corner:

- 1997: Set 3" dia. aluminum cap stamped to identify the corner over the existing 1/2" iron rod in the existing Monument Box.
Witnesses are:
Exis. tag in P. Pole - N45E - 50.59'
Exis. tag in 8" Maple - N45W - 51.01'
1/2" iron rod property corner - Due North - 33.02'
Set tag P.S. #31591 in 10" Elm - N46W - 63.27'

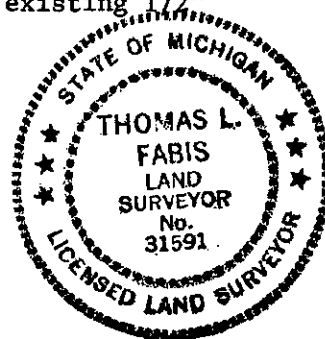

Signed by Thomas L. Fabis

Date July 31, 1997

Surveyor's Michigan License No. 31591