

SURVEY & REMONUMENTATION

FEB 03 1998

1997 ALPENA COUNTY REMONUMENTATION CORNER

LAND CORNER RECORDATION CERTIFICATE
Filing Requirement of Act 74, Mich. P.A. 1970

SECTION

For corners in

Alpena
(County)

Located In:

Corner Code #

Liber **00002** Page **0082**

STATE OF MICHIGAN
 County of Alpena
 Recorded
 08-06-1997 10:45:17
 Kathy J. Matash
 REGISTER OF DEEDS

Register of Deeds Stamp & File Number

1. Public Land Survey	T	<u>30N</u>	R	<u>5E</u>	<u>M-6 (E1, 13)</u>
	T	_____	R	_____	<u>Green Twp.</u>
	T	_____	R	_____	_____
	T	<u>30N</u>	R	<u>6E</u>	<u>A-6 (W1, 18)</u>
2. Property Controlling in Section	S	_____	T	_____	<u>Green Twp.</u>
	S	_____	T	_____	_____
3. Miscellaneous Property in Section	S	_____	T	_____	_____
	S	_____	T	_____	_____

4. Lot No. _____, Recorded Plat _____

5. Private Claims _____

I, Thomas L. Fabis, in a field survey on May 12, 19 97, do hereby certify that under requirements of P.A. 74, Michigan P.A. of 1970, the corner points mentioned in lines 1 and 2 above were in conformance with regulations and rules therefore as required in the current manual of survey instructions of the United States Department of the Interior, Bureau of Land Management or by a decree of a Court of Law and/or that the corner points mentioned in lines 3, 4 and 5 above were in conformance with the rules of the Michigan Board of Professional Surveyors or by a Decree of a Court of Law; established, re-established, monumented, re-monumented, recovered, found as expressed below:

NOTE: Not more than 4 corners, all in the same town and range, may be recorded on this certificate.

	A	B	C	D	E	F	G	H	I	J	K	L	M
2	6		5		4		3		2		1		
3													
4	7		8		9		10		11		12		
5													
6	18		17		16		15		14		13		
7													
8	19		20		21		22		23		24		
9													
10	30		29		28		27		26		25		
11													
12	31		32		33		34		35		36		
13													

A. Description of original monument and accessories and/or subsequent restoration:

- 1840: G.L.O. Survey by Lewis Clason - Set post & referenced: (Hem 26 N24W 27, Beech 8 S40W 34).
- 1907: County Survey by Wm. LeRoy - Set cedar stake 3" sq. in Road.
- 1922: County Survey by Wm. LeRoy - replaced old stake with 2" galvanized Pipe 18" long.
- 1994: Survey Liber 2 Page 739 by Earl T. Lewis - Exist. 1 1/2" Pipe & referenced.
- 1994: Survey Notes by Farrier Surveying - 3" Iron pipe pinched & bent.
- 1996: Survey Notes by Dan Kibbe of Wilcox & Assoc. - Found P.K. in pipe.

B. Description of corner evidence found and/or method applied in restoring or reestablishing corner:

- 1997: Found 1 1/2" Pipe and one witness (P. Pole - 35.38' - S68E) as per 1994 Earl T. Lewis Survey.


The position of this corner is compatible with county and local surveys and is accepted as a careful and faithful perpetuation of the position of the original corner.

P.A. 345 ALPENA COUNTY
 PEER APPROVED 6/19/97

D. J. B. [Signature]

C. Description of monument for corner and accessories established to perpetuate locating the position of the corner:

- 1997: Removed existing 1 1/2" Pipe and replaced with 1/2" iron rod with 3" dia. aluminum cap, stamped to identify the corner.
- Set tag P.S.#31591 in the following reestablished witnesses:
 - Fe. Cor. - East - 32.02'
 - 20" Aspen - S60W - 53.60'
 - 18" Aspen - N60W - 58.37'
- Exis: tag in Power Pole - S68E - 35.30'

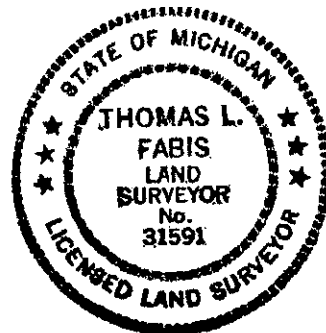

Signed by Thomas L. Fabis

Date July 31, 1997

Surveyor's Michigan License No. 31591