

# SURVEY & REMONUMENTATION

FEB 03 1998 1997 ALPENA COUNTY REMONUMENTATION CORNER

## SECTION LAND CORNER RECORDATION CERTIFICATE

Filing Requirement of Act 74, Mich. P.A. 1970

Liber 00002 Page 0078

STATE OF MICHIGAN  
County of Alpena  
Recorded  
08-06-1997 10:44:35  
Kathy J. Matash  
REGISTER OF DEEDS

Register of Deeds Stamp & File Number

For corners in	Alpena	Located In:	Corner Code #
	(County)		
1. Public Land Survey	T 30N R 5E	M-7 (NE, 24)	Green Twp.
	T R		
	T R		
	T 30N R 6E	A-7 (NW, 19)	Green Twp.
2. Property Controlling in Section	S T R		
	S T R		
3. Miscellaneous Property in Section	S T R		
	S T R		
4. Lot No. _____, Recorded Plat _____			
5. Private Claims _____			

A	B	C	D	E	F	G	H	I	J	K	L	M
2	6	5	4	3	2	1						
3												
4	7	8	9	10	11	12						
5												
6	16	17	16	15	14	13						
7												
8	19	20	21	22	23	24						
9												
10	30	29	28	27	26	25						
11												
12	31	32	33	34	35	36						
13												

I, Thomas L. Fabis, in a field survey on May 12, 1997 do hereby certify that under requirements of P.A. 74, Michigan P.A. of 1970, the corner points mentioned in lines 1 and 2 above were in conformance with regulations and rules therefore as required in the current manual of survey instructions of the United States Department of the Interior, Bureau of Land Management or by a decree of a Court of Law and/or that the corner points mentioned in lines 3, 4 and 5 above were in conformance with the rules of the Michigan Board of Professional Surveyors or by a Decree of a Court of Law; established, re-established, monumented, re-monumented, recovered, found as expressed below:


NOTE: Not more than 4 corners, all in the same town and range, may be recorded on this certificate.

- A. Description of original monument and accessories and/or subsequent restoration:**  
 1840: G.L.O. Survey by Lewis Clason - Set post & referenced: (Cedar 12 S38W 71, Hem 10 N37W 70).  
 1888 & 1893: County Surveys by Fred A. Rice - Visits corner.  
 1922: County Survey by Wm. LeRoy - Replaced old corner with 2" Galvanized pipe 3' long in Road & referenced.  
 1988: Alpena County Road Commission Survey Notes by Gary St. Charles - Found corner & referenced.  
 1994: Survey Liber 2 Page 739 by Earl T. Lewis - Set 1/2" Rod & referenced.  
 1994: Survey Notes by Farrier Surveying - Found 1/2" iron rod.  
 1995 & 1996: Survey Notes by Dan Kibbe of Wilcox & Assoc.-Found 1/2" Bar in centerline of roads.
- B. Description of corner evidence found and/or method applied in restoring or reestablishing corner:**  
 1997: Found 1/2" iron rod and two existing witnesses: N45E - P. Pole - 43.0', N60W - Anchor Pole - 45.68', which matches the 1994 Survey by Earl T. Lewis.

The position of this corner is compatible with county and local surveys and is accepted as a careful and faithful perpetuation of the position of the original corner.

P.A. 345 ALPENA COUNTY  
PEER APPROVED 6/19/97  
*D.D.B. Coon*

- C. Description of monument for corner and accessories established to perpetuate locating the position of the corner:**  
 1997: Set 3" dia. aluminum cap, stamped to identify the corner, over the existing 1/2" iron rod.  
 Reestablished witnesses are:  
 P. Pole - N45E - 43.00'  
 Anchor Pole - N60W - 45.68'  
 10" Twin Cedar - S40E - 77.82'  
 8" W. Birch - S65W - 65.50'

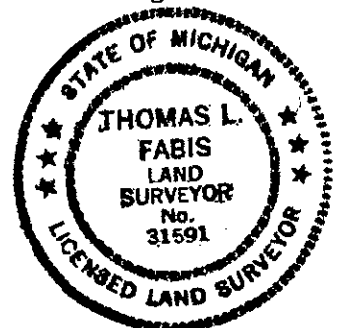

Signed by Thomas L. Fabis

Date July 31, 1997

Surveyor's Michigan License No. 31591