

# SURVEY & REMONUMENTATION

FEB 03 1998

1997 ALPENA COUNTY REMONUMENTATION CORNER

## LAND CORNER RECORDATION CERTIFICATE

Filing Requirement of Act 74, Mich. P.A. 1970

### SECTION

For corners in

Alpena  
(County)

Located In:

Corner Code #

Liber **00002** Page **0072**

1. Public Land Survey	T	<u>30N</u>	R	<u>5E</u>	<u>M-8 (E<math>\frac{1}{2}</math>, 24)</u>
	T	_____	R	_____	<u>Green Twp.</u>
	T	<u>30N</u>	R	<u>6E</u>	<u>A-8 (W<math>\frac{1}{2}</math>, 19)</u>
	T	_____	R	_____	<u>Green Twp.</u>
2. Property Controlling in Section	S	_____	T	_____	_____
	S	_____	T	_____	_____
3. Miscellaneous Property in Section	S	_____	T	_____	_____
	S	_____	T	_____	_____

STATE OF MICHIGAN  
County of Alpena  
Recorded  
08-06-1997 10:43:28  
Katha J. Matash  
REGISTER OF DEEDS

Register of Deeds Stamp & File Number

4. Lot No. \_\_\_\_\_, Recorded Plat \_\_\_\_\_  
5. Private Claims \_\_\_\_\_

	A	B	C	D	E	F	G	H	I	J	K	L	M
2	6		5		4		3		2				
3													
4	7		8		9		10		11		12		
5													
6	18		17		16		15		14		13		
7													
8	19		20		21		22		23		24		
9													
10	30		29		28		27		26		25		
11													
12	31		32		33		34		35		36		
13													

I, Thomas L. Fabis, in a field survey on May 12, 1997, do hereby certify that under requirements of P.A. 74, Michigan P.A. of 1970, the corner points mentioned in lines 1 and 2 above were in conformance with regulations and rules therefore as required in the current manual of survey instructions of the United States Department of the Interior, Bureau of Land Management or by a decree of a Court of Law and/or that the corner points mentioned in lines 3, 4 and 5 above were in conformance with the rules of the Michigan Board of Professional Surveyors or by a Decree of a Court of Law; established, re-established, monumented, re-monumented, recovered, found as expressed below:

NOTE: Not more than 4 corners, all in the same town and range, may be recorded on this certificate.

**A. Description of original monument and accessories and/or subsequent restoration:**

- 1840: G.L.O. Survey by Lewis Clason - Set post & referenced: (Hem 12 S62W 41, Do 12 N40W 20).
- 1888 & 1893: County Surveys by Fred A. Rice - Estab. stake and made new witness: Dead Pine Stub 36 S42E 76
- 1995: Survey Notes by Wilcox & Associates - Found no corner evidence except occupation fence line to the East.

**B. Description of corner evidence found and/or method applied in restoring or reestablishing corner:**


1997: Set 1/2" iron rod midway and on line between M-7 and M-9 T30N R5E.

The position of this corner best harmonizes with the 1/8 line fences to the North and the 1/4 line fence to the East. It is compatible with early county surveys and is accepted as a careful and faithful reestablishment of the position of the original corner.

P.A. 345 ALPENA COUNTY  
PEER APPROVED 6/19/97  
*D. B. Curran*

**C. Description of monument for corner and accessories established to perpetuate locating the position of the corner:**

- 1997: Set 3" dia. aluminum cap, stamped to identify the corner, over the 1/2" iron rod. Reestablished the following witnesses:  
Set tag in Fe. Post - S45E - 39.13'  
Set tag in Fe. Cor. Post - S8E - 27.75'  
Set tag in Fe. Post - N60E - 31.09'  
Center of Gas Valve - N10W - 188.51'

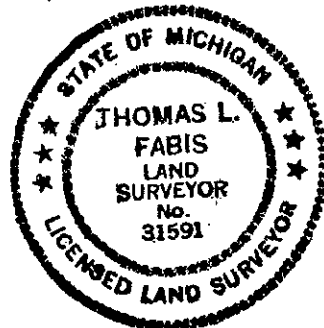

Signed by Thomas L. Fabis

Date July 31, 1997

Surveyor's Michigan License No. 31591