

SURVEY & REMONUMENTATION

FEB 03 1998

1997 ALPENA COUNTY REMONUMENTATION CORNER

SECTION

LAND CORNER RECORDATION CERTIFICATE
Filing Requirement of Act 74, Mich. P.A. 1970

For corners in

Alpena
(County)

Located In:

Corner Code #

- | | | | | | |
|--------------------------------------|---|------------|---|-----------|----------------------------------------------|
| 1. Public Land Survey | T | <u>30N</u> | R | <u>5E</u> | <u>M-10 (E 1/2, 25)</u>
<u>Green Twp.</u> |
| | T | | R | | |
| | T | | R | | |
| | T | <u>30N</u> | R | <u>6E</u> | <u>A-10 (W 1/2, 30)</u>
<u>Green Twp.</u> |
| 2. Property Controlling in Section | S | | T | | |
| | S | | T | | |
| 3. Miscellaneous Property in Section | S | | T | | |
| | S | | T | | |

Liber **00002** Page **0074**
 STATE OF MICHIGAN
 County of Alpena
 Recorded
 08-06-1997 10:43:50
 Kathy J. Matash
 REGISTER OF DEEDS

Register of Deeds Stamp & File Number

4. Lot No. _____, Recorded Plat _____
 5. Private Claims _____

A	B	C	D	E	F	G	H	I	J	K	L	M
2	6	5	4	3	2	1						
3												
4	7	6	5	4	3	2	1					
5												
6	18	17	16	15	14	13						
7												
8	19	20	21	22	23	24						
9												
10	30	29	28	27	26	25						
11												
12	31	32	33	34	35	36						
13												

I, Thomas L. Fabis, in a field survey on May 12, 1997
do hereby certify that under requirements of P.A. 74, Michigan P.A. of 1970, the corner points mentioned in lines 1 and 2 above were in conformance with regulations and rules therefore as required in the current manual of survey instructions of the United States Department of the Interior, Bureau of Land Management or by a decree of a Court of Law and/or that the corner points mentioned in lines 3, 4 and 5 above were in conformance with the rules of the Michigan Board of Professional Surveyors or by a Decree of a Court of Law; established, re-established, monumented, re-monumented, recovered, found as expressed below:

NOTE: Not more than 4 corners, all in the same town and range, may be recorded on this certificate.


- A. Description of original monument and accessories and/or subsequent restoration:**
 1840: G.L.O. Survey by Lewis Clason - Set post & referenced: Hd. Maple 18 S71W 47, Beech 12 N40W 51.
 1912: County Survey by Jos. McNeil - Set post & made N.W.T.'s.
 1967: Survey W.O. 4-3556 by Robert Paquette of R.S.Scott Eng. Co. - Used corner.
 1973: Surveys: Liber 1 Page 196 & Liber 1 Page 197 by James Scott - Used corner.
 1993: Survey Notes by Dan Kibbe of Wilcox & Assoc. - Found pipe.
 1994: Survey W.O. 4-2363A by Earl T. Lewis - Found 1 1/2" Pin & referenced.

- B. Description of corner evidence found and/or method applied in restoring or reestablishing corner:**
 1997: Found Iron Bar and 3 existing witnesses as per 1994 Earl T. Lewis Survey W.O. 4-2363A.

The position of this corner is compatible with county and local surveys and is accepted as a careful and faithful perpetuation of the position of the original corner.

P.A. 345 ALPENA COUNTY
 PEER APPROVED 6/19/97
Det. B. [Signature]

- C. Description of monument for corner and accessories established to perpetuate locating the position of the corner:**
 1997: Set 1/2" iron rod capped with 3" dia. aluminum cap stamped to identify the corner, next to the existing Iron Bar.
 Witnesses are:
 Existing in P. Pole - West - 36.66'
 Exis. tag in 12" W. Pine - N17E - 59.6'
 Exis. tag in 5" W. Pine - S65E - 27.75'
 Set tag #31591 in 30" W. Pine - N50E - 58.16'

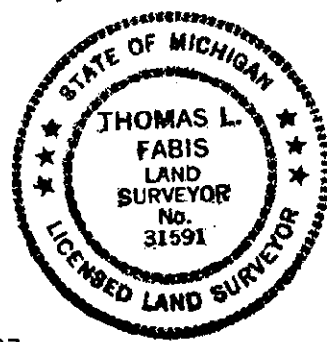

Signed by Thomas L. Fabis

Date July 31, 1997

Surveyor's Michigan License No. 31591