

# SURVEY & REMONUMENTATION

FEB 03 1998

1997 ALPENA COUNTY REMONUMENTATION CORNER

## LAND CORNER RECORDATION CERTIFICATE Filing Requirement of Act 74, Mich. P.A. 1970

SECTION

For corners in

Alpena  
(County)

Located In:

Corner Code #

Liber **00002** Page **0076**

STATE OF MICHIGAN  
County of Alpena  
Recorded  
08-06-1997 10:44:14  
Kathy J. Matash  
REGISTER OF DEEDS

Register of Deeds Stamp & File Number

- |                                      |   |            |   |           |                     |
|--------------------------------------|---|------------|---|-----------|---------------------|
| 1. Public Land Survey                | T | <u>30N</u> | R | <u>5E</u> | <u>M-9 (SE, 24)</u> |
|                                      | T | _____      | R | _____     | <u>Green Twp.</u>   |
|                                      | T | _____      | R | _____     |                     |
|                                      | T | <u>30N</u> | R | <u>6E</u> | <u>A-9 (SW, 19)</u> |
| 2. Property Controlling in Section   | S | _____      | T | _____     | <u>Green Twp.</u>   |
|                                      | S | _____      | T | _____     |                     |
| 3. Miscellaneous Property in Section | S | _____      | T | _____     |                     |
|                                      | S | _____      | T | _____     |                     |

4. Lot No. \_\_\_\_\_, Recorded Plat \_\_\_\_\_  
5. Private Claims \_\_\_\_\_

	A	B	C	D	E	F	G	H	I	J	K	L	M
2	6		6		4		3		2		1		
3													
4	7		8		9		10		11		12		
5													
6	18		17		16		15		14		13		
7													
8	19		20		21		22		23		24		
9													
10	30		29		28		27		26		25		
11													
12	31		32		33		34		35		36		
13													

Thomas L. Fabis, in a field survey on May 12, 1997

do hereby certify that under requirements of P.A. 74, Michigan P.A. of 1970, the corner points mentioned in lines 1 and 2 above were in conformance with regulations and rules therefore as required in the current manual of survey instructions of the United States Department of the Interior, Bureau of Land Management or by a decree of a Court of Law and/or that the corner points mentioned in lines 3, 4 and 5 above were in conformance with the rules of the Michigan Board of Professional Surveyors or by a Decree of a Court of Law; established, re-established, monumented, re-monumented, recovered, found as expressed below:

**NOTE: Not more than 4 corners, all in the same town and range, may be recorded on this certificate.**


- A. Description of original monument and accessories and/or subsequent restoration:
- 1840: G.L.O. Survey by Lewis Clason - Set post & referenced: (W. Pine 36 S45W 52, Beech 16 N74W 26).
  - 1888 & 1893: County Survey by Fred A. Rice - Stake on Range line.
  - 1907 & 1912: County Survey by Jos. McNeil - Set new cedar stake 4" sq. in road bed.
  - 1973: Survey Liber 1 Page 197 by James Scott - Visits corner.
  - 1993 & 1995: Survey Notes by Dan Kibbe of Wilcox & Assoc. - Found pipe.
  - 1995: Survey W.O. 4-2517-M by Earl T. Lewis - Existing 1/2" rerod & referenced.

- B. Description of corner evidence found and/or method applied in restoring or reestablishing corner:
- 1997: Found 1/2" iron rod and all four witnesses as per the 1995 Earl T. Lewis Survey W.O. 4-2517-M.

The position of this corner is compatible with county and local surveys and is accepted as a careful and faithful perpetuation of the position of the original corner.

P.A. 345 ALPENA COUNTY  
PEER APPROVED 6/19/97  
*D. J. R. Curran*

- C. Description of monument for corner and accessories established to perpetuate locating the position of the corner:
- 1997: Set 3" dia. aluminum cap, stamped to identify the corner, over the existing 1/2" iron rod.
- Witnesses are:
- P. Pole - N50W - 49.80'
  - Tele. Post - N42E - 48.50'
  - P. Pole - S45W - 50.30'
  - 5" W. Pine - S15E - 87.93'

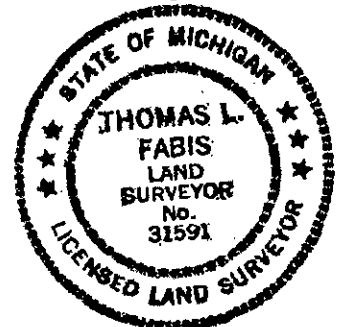

signed by Thomas L. Fabis

Date July 31, 1997

Surveyor's Michigan License No. 31591