

**SURVEY & REMONUMENTATION**

**FEB 03 1998**

1997 ALPENA COUNTY REMONUMENTATION CORNER

**LAND CORNER RECORDATION CERTIFICATE**

Filing Requirement of Act 74, Mich. P.A. 1970

For corners in **SECTION**

Alpena  
(County)

Located In:

Corner Code #

Liber **00002** Page **0087**

1. Public Land Survey	T	<u>30N</u>	R	<u>5E</u>	<u>M-11, (SE, 25)</u>
	T	_____	R	_____	<u>Green Twp.</u>
	T	_____	R	_____	_____
	T	<u>30N</u>	R	<u>6E</u>	<u>A-11, (SW, 30)</u>
2. Property Controlling in Section	S	_____	T	_____	<u>Green Twp.</u>
	S	_____	T	_____	_____
3. Miscellaneous Property in Section	S	_____	T	_____	_____
	S	_____	T	_____	_____

STATE OF MICHIGAN  
County of Alpena  
Recorded  
08-06-1997 10:46:14  
Kathy J. Matash  
REGISTER OF DEEDS

Register of Deeds Stamp & File Number

4. Lot No. \_\_\_\_\_, Recorded Plat \_\_\_\_\_  
5. Private Claims \_\_\_\_\_

A	B	C	D	E	F	G	H	I	J	K	L	M
2	6	5	4	3	2							
3												
4	7	8	9	10	11	12						
5												
6	18	17	16	15	14	13						
7												
8	19	20	21	22	23	24						
9												
10	30	29	28	27	26	25						
11												
12	31	32	33	34	35	36						
13												

I, Thomas L. Fabis, in a field survey on May 18, 19 97, do hereby certify that under requirements of P.A. 74, Michigan P.A. of 1970, the corner points mentioned in lines 1 and 2 above were in conformance with regulations and rules therefore as required in the current manual of survey instructions of the United States Department of the Interior, Bureau of Land Management or by a decree of a Court of Law and/or that the corner points mentioned in lines 3, 4 and 5 above were in conformance with the rules of the Michigan Board of Professional Surveyors or by a Decree of a Court of Law; established, re-established, monumented, re-monumented, recovered, found as expressed below:

**NOTE: Not more than 4 corners, all in the same town and range, may be recorded on this certificate.**

**A. Description of original monument and accessories and/or subsequent restoration:**

- 1840: G.L.O. Survey Lewis Clason-Set post & referenced: (S. Maple 8 S52W 32, Do 10 N10W 40)
- 1912: County Survey Jos. McNeill+ Set Large cedar stake & made N.W.T.'s.
- 1959: MSHD Survey Chas. Robinson - Set 1" Bar & referenced.
- 1960: Survey Thomas Beaudrie - Used corner
- 1960: Survey Witness Records Delmer Porter - Found 1" sq. Iron Rod & referenced.
- 1984: Survey Liber 2 Page 236 Duane MacNeill - Found Mon. Box.
- 1993: Survey Notes Dan Kibbe of Wilcox Assoc.- Found Mon. Box.
- 1993: L.C.R.C. Liber 1 Page 294 Clifford Lindgren - Found 1" sq. Bar in Mon. Box. Reset 1/2" Re-rod in Mon. Box & referenced.
- 1994: Survey W.O. 4-2363A Earl Lewis - Found 1/2" reroed in Mon. Box & referenced.

**B. Description of corner evidence found and/or method applied in restoring or reestablishing corner:**

1997: Found 1/2" iron rod in Mon. Box and 3 existing references indicating this is the same corner position used by the surveyors mentioned above.

The position of this corner is accepted as a careful and faithful perpetuation of the position of the original corner.


P.A. 345 ALPENA COUNTY  
PEER APPROVED 6/19/97  
*D.J.B. Cur*

**C. Description of monument for corner and accessories established to perpetuate locating the position of the corner:**

1997: Set 3" dia. aluminum cap stamped to identify the corner over the existing 1/2" iron rod in the existing Mon. Box.

Witnesses are:

- Exis. Hwy. Tag in P. Pole - N70E - 99.99'
- Exis. tag in P. Pole - N40W - 169.45'
- Exis. tag in P. Pole stump - S50W - 77.7'
- Set tag P.S. #31591 in P. Pole - N80W - 150.63'

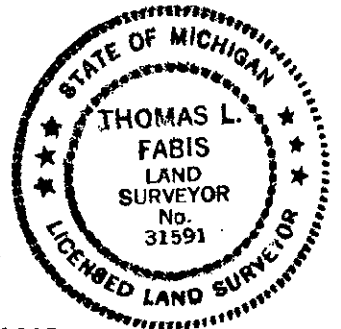

Signed by Thomas L. Fabis

Date July 31, 1997

Surveyor's Michigan License No. 31591