

# SURVEY & REMONUMENTATION

FEB 03 1998

1997 ALPENA COUNTY REMONUMENTATION CORNER

## LAND CORNER RECORDATION CERTIFICATE

Filing Requirement of Act 74, Mich. P.A. 1970

### SECTION

For corners in

Alpena  
(County)

Located In:


Corner Code #

- |                                      |   |                       |   |
|--------------------------------------|---|-----------------------|---|
| 1. Public Land Survey                | T | <u>30NR 6E</u>        | <u>B-5, (N<math>\frac{1}{2}</math>. 18)</u> |
|                                      | T | _____ R _____         | <u>Green Twp.</u>                           |
|                                      | T | _____ R _____         | _____                                       |
|                                      | T | _____ R _____         | _____                                       |
| 2. Property Controlling in Section   | S | _____ T _____ R _____ | _____                                       |
|                                      | S | _____ T _____ R _____ | _____                                       |
| 3. Miscellaneous Property in Section | S | _____ T _____ R _____ | _____                                       |
|                                      | S | _____ T _____ R _____ | _____                                       |

Liber 00002 Page 0086  
 STATE OF MICHIGAN  
 County of Alpena  
 Recorded  
 08-06-1997 10:46:02  
 Kathy J. Matash  
 REGISTER OF DEEDS

Register of Deeds Stamp & File Number

4. Lot No. \_\_\_\_\_, Recorded Plat \_\_\_\_\_  
 5. Private Claims \_\_\_\_\_

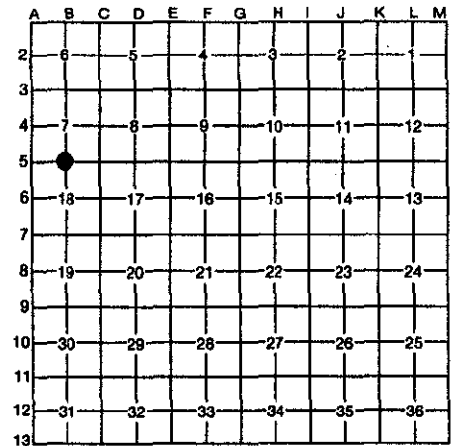

I, Thomas L. Fabis, in a field survey on May 12, 1997, do hereby certify that under requirements of P.A. 74, Michigan P.A. of 1970, the corner points mentioned in lines 1 and 2 above were in conformance with regulations and rules therefore as required in the current manual of survey instructions of the United States Department of the Interior, Bureau of Land Management or by a decree of a Court of Law and/or that the corner points mentioned in lines 3, 4 and 5 above were in conformance with the rules of the Michigan Board of Professional Surveyors or by a Decree of a Court of Law; established, re-established, monumented, re-monumented, recovered, found as expressed below:

**NOTE: Not more than 4 corners, all in the same town and range, may be recorded on this certificate.**

**A. Description of original monument and accessories and/or subsequent restoration:**

- 1840: G.L.O. Survey Lewis Clason - Set post & referenced: (Beech 12' N55W 38, Do 8 S49E 50)
- 1907: County Survey Jos. McNeil - Found corner and O.B.T.
- 1929: County Survey Wm. LeRoy - Set 4" sq. Cedar stake
- 1970's: County Rd. Comm. Notes Gary St. Charles - Found 3/4" iron pipe & referenced.
- 1974: Survey Liber 284 Page 780 L&C.R.C. Liber 1 Page 47 Delmer Porter - Found 3/4" iron pipe 2' deep, raised with 1/2" Rod & cap and referenced.
- 1993: Survey W.O. 4-1779 Earl Lewis - Found Monument Box & referenced.
- 1994: Survey Notes Farrier Surveying - Found iron & cap in Mon. Box.
- 1996: Field Notes Dan Kibbe - Found B. & C. in Mon. Box.

**B. Description of corner evidence found and/or method applied in restoring or reestablishing corner:**

- 1997: Found 1/2" iron rod capped P.S. #15410 in Mon. Box 1.5' North of Moores Landing Road centerline (paved surface). Also found 2 witnesses indicating this is the same corner position used by the surveyors mentioned above.

The position of this corner is accepted as a careful and faithful perpetuation of the position of the original corner.

P.A. 345 ALPENA COUNTY  
 PEER APPROVED 6/19/97

*Thomas L. Fabis*

**C. Description of monument for corner and accessories established to perpetuate locating the position of the corner:**

- 1997: Removed existing plastic cap and set 3" dia. aluminum cap, stamped to identify the corner over the existing 1/2" iron rod in existing Mon. Box.

Witnesses are:

- Exis. tag in P. Pole - N26E - 45.55'
- Set tag P.S. #31591 in 7" Ash - S26E - 36.23'
- Set tag P.S. #31591 in 5" Elm - S60W - 58.75'
- Set tag P.S. #31591 in 5" Ash - S65E - 65.77'



Signed by Thomas L. Fabis

Date July 31, 1997

Surveyor's Michigan License No. 31591