

FEB 03 1998

1997 ALPENA COUNTY REMONUMENTATION CORNER

LAND CORNER RECORDATION CERTIFICATE

Filing Requirement of Act 74, Mich. P.A. 1970

SECTION

For corners in

Alpena
(County)

Located In:

Corner Code #


- | | | | |
|--------------------------------------|---|-----------------------|-----------------------------|
| 1. Public Land Survey | T | <u>30N R 6E</u> | <u>C-5, (NE, 18)</u> |
| | T | <u> R </u> | <u>Green Twp.</u> |
| | T | <u> R </u> | <u> </u> |
| | T | <u> R </u> | <u> </u> |
| 2. Property Controlling in Section | S | <u> T R </u> | <u> </u> |
| | S | <u> T R </u> | <u> </u> |
| 3. Miscellaneous Property in Section | S | <u> T R </u> | <u> </u> |
| | S | <u> T R </u> | <u> </u> |

Liber **00002** Page **0077**

STATE OF MICHIGAN
County of Alpena
Recorded
08-06-1997 10:44:24
Kathy J. Natash
REGISTER OF DEEDS

Register of Deeds Stamp & File Number

4. Lot No. _____, Recorded Plat _____
5. Private Claims _____

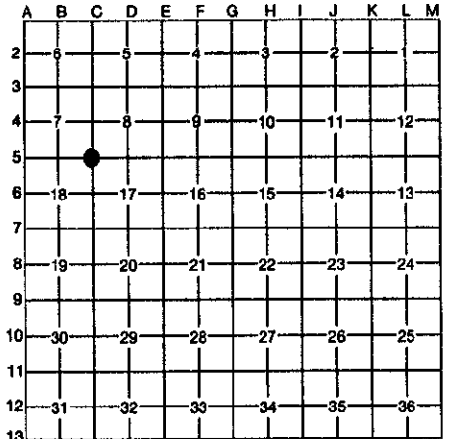

I, Thomas L. Fabis, in a field survey on May 12, 1997, do hereby certify that under requirements of P.A. 74, Michigan P.A. of 1970, the corner points mentioned in lines 1 and 2 above were in conformance with regulations and rules therefore as required in the current manual of survey instructions of the United States Department of the Interior, Bureau of Land Management or by a decree of a Court of Law and/or that the corner points mentioned in lines 3, 4 and 5 above were in conformance with the rules of the Michigan Board of Professional Surveyors or by a Decree of a Court of Law; established, re-established, monumented, re-monumented, recovered, found as expressed below:

NOTE: Not more than 4 corners, all in the same town and range, may be recorded on this certificate.

A. Description of original monument and accessories and/or subsequent restoration:

- 1840: G.L.O. Survey Lewis Clason - Set post & referenced: (Spruce 4 S68W 23, Tam 9 N59E 121).
- 1901: County Survey Wm. LeRoy - Found Cedar stake 3" sq.
- 1929: County Survey Wm. LeRoy - Replaced old stake in Road with 1 1/2" Iron pipe.
- 1974: Survey Liber 284 Page 780 & L.C.R.C. Liber 1 Page 71 Delmer Porter-Boat Spike in Mon. Box.
- 1981: Survey Liber 2 Page 46 Duane MacNeill - Found Monument Box.
- 1987: Survey Liber 2 Page 426 Earl Lewis - Existing Monument Box & referenced.
- 1993: L.C.R.C. Liber 1 Page 294 Clifford Lindgren - Found 1" sq. Bar in Mon. Box. Reset 1/2" re-rod in Mon. Box and referenced.
- 1994: Survey Notes Farrier Surveying - Found 1/2" iron rod in Mon. Box.
- 1996: Survey Notes Dan Kibbe of Wilcox & Assoc. - Found 1/2" Bar in Mon. Box.

B. Description of corner evidence found and/or method applied in restoring or reestablishing corner:

- 1997: Found 1/2" iron rod in Mon. Box 5.8' East of M-65 centerline, 1' North of Moores Landing Rd. centerline and on line with Old Fence to the East. Also found one existing witness: (Lewis tag and MDOT tag in P. Pole - N65W - 90.10').

The position of this corner is compatible with county and local surveys and is accepted as a careful and faithful perpetuation of the position of the original corner.

P.A. 345 ALPENA COUNTY
PEER APPROVED 6/19/97
D.J.B. [Signature]

C. Description of monument for corner and accessories established to perpetuate locating the position of the corner:

- 1997: Set 3" dia. aluminum cap, stamped to identify the corner, over the existing 1/2" iron rod inside the existing Mon. Box.

Witnesses are:

- Set tag P.S. #31591 in Wood Sign Post - East - 70.45'
- Center of road sign post - N44W - 53.60'
- Center of East end of conc. culvert - S30E - 62.00'
- Exis. MDOT tag in P. Pole - N65W - 90.10'



Signed by Thomas L. Fabis

Date July 31, 1997

Surveyor's Michigan License No. 31591