

**1999 Alpena County Remonumentation Corner
LAND CORNER RECORDATION CERTIFICATE
Filing Requirement of Act 74, Mich. P.A. 1970**

RECORDED

JAN 21 2000

For corners in

Alpena
(County)

Located In:

Corner Code #

SECTION

1. Public Land Survey

T 30N R6E

C-13

2. Property Controlling
in Section

S T R
S T R

3. Miscellaneous
Property in Sec.

S T R
S T R

L-2 P- 285
12/10/1999 01:39P
Page: 1 of 1
Kathy J. Matash, Register Alpena Co., MI LDC 9.00

Register of Deeds Stamp & File Number

4. Lot No. _____, Recorded Plat _____
5. Private Claims _____

I, Daniel T. Kibbe, in a field survey on June 14, 1999 do hereby state that under requirements of P.A. 74, Michigan P.A. of 1970, the corner points mentioned in lines 1 and 2 above were in conformance with regulations and rules therefore as required in the current manual of survey instructions of the United States Department of the Interior, Bureau of Land Management or by a decree of a Court of Law and /or that the corner points mentioned in lines 3, 4 and 5 above were in conformance with the rules of the Michigan Board of Land Surveyors or by a Decree of a Court of Law; established, re-established, monumented, recovered, found as expressed below:

A	B	C	D	E	F	G	H	I	J	K	L	M
1												
2	6	5	4	3	2	1						
3												
4	7	8	9	10	11	12						
5												
6	16	17	16	15	14	13						
7												
8	19	20	21	22	23	24						
9												
10	30	29	28	27	26	25						
11												
12	31	32	33	34	35	36						
13												

NOTE: Not more than 2 corners, all in the same town and range, may be recorded on this certificate

A. Description of original monument and accessories and/or subsequent restoration:

- 1839: GLO Survey by Lewis Clason: Set post corner Sections 31 & 32. Referenced: W. Birch 10-N41E-16/W. Birch 5-N42W-19.
- 1906: County Survey by Wm. H. LeRoy: Re-established old corner, cedar stake 3" sq. Referenced: W. Birch stump 12-N71E-16 (OBT)/W. Birch stump 10-N42W-19 (OBT)/W. Pine stump 36-N47E-73.5 (NWT)/ W. Pine stump 30-S9.5W-131 (NWT).
- 1908: County Survey by Jos. W. McNeil: Corner set by LeRoy from OBT's according to field notes, corner 31 & 32 should be 65 links West of corner 5 & 6-it is probably due to some mistake in copying the notes. (Per Joseph W. McNeil)
- 1977: Survey by David B. Guthrie: Existing 1" iron bar. Referenced: Power Pole-West 36.40/10" Birch-S45E-66.10"/Tele. Maker Post-N45E-38.60'.
- 1977: Recorded Corner by David B. Guthrie: Existing 1" iron bar set by others. Referenced: Power Pole-West 36.40/10" Birch-S45E-66.10"/Tele. Maker Post-N45E-38.60'.
- 1986: Survey by David B. Guthrie: Existing 1" Iron Bar. Referenced: 10" Spruce-N25W-73.65/30" Oak-N70E-68.50'-Utility Pole-S45E-44.75'
- 05/96: Survey by Daniel T. Kibbe: Found 1" Iron Bar of record.
- 11/96: Survey by Daniel T. Kibbe: Found 1" Iron Bar of record.
- 1997: Survey by Daniel T. Kibbe: Found 1" Bar of record.
- 1998: Survey Notes by David B. Guthrie: Existing 1" bar.

B. Description of corner evidence found and/or method applied in restoring or reestablishing corner:

- 1999: Remon. Survey by Daniel T. Kibbe-Found 1 1/4" pipe CL road to N., 6' N. of CL E-W road.


This corner position is compatible with county & local surveys. This corner position is accepted as a careful and faithful perpetuation of the position of the original corner.

C. Description of monument for corner and accessories established to perpetuate locating the position of the corner:

- 1999: Placed 3" Alpena County cap stamped to identify the corner over 1/2" iron rod.
Referenced:
1/2" rebar C-1 West 43.15'
Power Pole-set tag - N44 E 86.09'
Rd. Sign Post - Beaver Lake Elevere Rd. S., S61 W 79.87'
Power pole set tag S34 E 44.65'

P.A. 345 ALPENA COUNTY
PEER APPROVED 9/16/99
D.T.B.

Signed by _____
Surveyor's Michigan License No. 37278

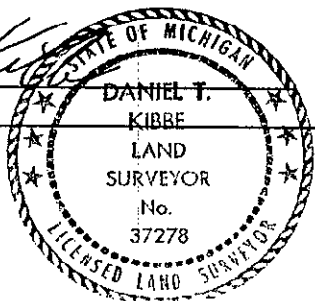

Date November 30, 1999