

1999 Alpena County Remonumentation Corner  
LAND CORNER RECORDATION CERTIFICATE  
Filing Requirement of Act 74, Mich. P.A. 1970

JAN 21 2000

SECTION

For corners in

<u>Alpena</u> (County)	Located In:	Corner Code #
1. Public Land Survey	T <u>30N</u> R <u>6E</u>	<u>D-13</u>
	T _____ R _____	
	T _____ R _____	
	T _____ R _____	
2. Property Controlling in Section	S _____ T _____ R _____	
	S _____ T _____ R _____	
3. Miscellaneous Property in Sec.	S _____ T _____ R _____	
	S _____ T _____ R _____	



L-2 P-284  
12/10/1999 01:39P  
Page: 1 of 1

Kathy J. Matash, Register Alpena Co., MI LDC 9.00

Register of Deeds Stamp & File Number

4. Lot No. \_\_\_\_\_, Recorded Plat \_\_\_\_\_  
5. Private Claims \_\_\_\_\_

1	A	B	C	D	E	F	G	H	I	J	K	L	M
2		6		5		4		3		2		1	
3													
4		7		8		9		10		11		12	
5													
6		18		17		16		15		14		13	
7													
8		19		20		21		22		23		24	
9													
10		30		29		28		27		26		25	
11													
12		31		32		33		34		35		36	
13													

I, Daniel T. Kibbe, in a field survey on June 14, 1999 do hereby state that under requirements of P.A. 74, Michigan P.A. of 1970, the corner points mentioned in lines 1 and 2 above were in conformance with regulations and rules therefore as required in the current manual of survey instructions of the United States Department of the Interior, Bureau of Land Management or by a decree of a Court of Law and /or that the corner points mentioned in lines 3, 4 and 5 above were in conformance with the rules of the Michigan Board of Land Surveyors or by a Decree of a Court of Law; established, re-established, monumented, recovered, found as expressed below:

NOTE: Not more than 2 corners, all in the same town and range, may be recorded on this certificate

A. Description of original monument and accessories and/or subsequent restoration:

- 1839: GLO Survey by Lewis Clason: Set 1/4 sec. post. Referenced: Hem. 15-N37E31/ Hem. 14-N18W-11.
- 1896: County Survey by Wm. H. LeRoy: Cedar stake 4" sq. Referenced: Dead Hem. 16-N37E-31 (OBT)/Hem. Stump 15-N18W-18 (OBT)
- 1997: Survey by Daniel T. Kibbe: Found no corner. Surveyed three miles of Beaver Lake Road and examined corner positions and occupation lines. Determined to set D-13 in CL road on fence line to North. Set 1/2" bar and cap. Referenced: P. Pole-S45E 60.54/8" Poplar-N09E - 35.63'/Willow Clump-S48E-56.61'/5" Poplar-N70E-88.29'
- 1998: Survey notes by David B. Guthrie: Existing 1/2" rod. Referenced: Fence corner-North-32.30'/P. Pole-S70W-92.11'/30" Willow-S47W-56.25'/P. Pole-S35E-60.38'

B. Description of corner evidence found and/or method applied in restoring or reestablishing corner:

- 1999: Remon. Survey by Daniel T. Kibbe-Found 1/2" rebar CL road, on fence line North.


This corner position is compatible with county & local surveys. This corner position is accepted as a careful and faithful perpetuation of the position of the original corner.

C. Description of monument for corner and accessories established to perpetuate locating the position of the corner:

- 1999: Placed 3" Alpena County cap stamped to identify the corner over 1/2" iron rod. Referenced:  
P. Pole-found tag 37278-S45 E 60.42'  
30" Willow-found tag 22435-S44 W 56.15'  
P. Pole-found tag 22435-S69 W 92.23'  
Fence Corner-found tag 22435-North 32.45'  
D-1 Remon. corner East-49.50'

P.A. 345 ALPENA COUNTY  
PEER APPROVED 9/16/99  
*D. J. B. [Signature]*

Signed by *Daniel T. Kibbe*  
Surveyor's Michigan License No. 37278

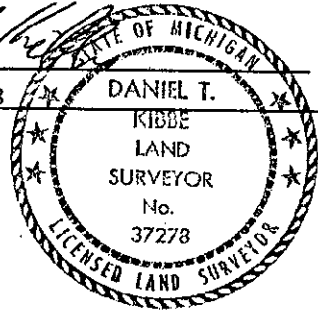

Date November 30, 1999