

**1999 Alpena County Remonumentation Corner
LAND CORNER RECORDATION CERTIFICATE
Filing Requirement of Act 74, Mich. P.A. 1970**

RECORDED

JAN 21 2000

For corners in

<u>Alpena</u> (County)	Located In:	Corner Code #
1. Public Land Survey	T <u>30N</u> RGE	<u>E-13</u>
	T _____ R _____	
	T _____ R _____	
	T _____ R _____	
2. Property Controlling in Section	S _____ T _____ R _____	
	S _____ T _____ R _____	
3. Miscellaneous Property in Sec.	S _____ T _____ R _____	
	S _____ T _____ R _____	

SECTION


L- 2 P- 283
 12/10/1999 01:39P
 Page: 1 of 1
 Kathy J. Matash, Register Alpena Co., MI LDC 9.00

Register of Deeds Stamp & File Number

4. Lot No. _____, Recorded Plat _____
 5. Private Claims _____

A	B	C	D	E	F	G	H	I	J	K	L	M
1												
2	6		5		4		3		2		1	
3												
4	7		8		9		10		11		12	
5												
6	18		17		16		15		14		13	
7												
8	19		20		21		22		23		24	
9												
10	30		29		28		27		26		25	
11												
12	31		32		33		34		35		36	
13												

I, Daniel T. Kibbe, in a field survey on June 14, 1999 do hereby state that under requirements of P.A. 74, Michigan P.A. of 1970, the corner points mentioned in lines 1 and 2 above were in conformance with regulations and rules therefore as required in the current manual of survey instructions of the United States Department of the Interior, Bureau of Land Management or by a decree of a Court of Law and /or that the corner points mentioned in lines 3, 4 and 5 above were in conformance with the rules of the Michigan Board of Land Surveyors or by a Decree of a Court of Law; established, re-established, monumented, recovered, found as expressed below:

NOTE: Not more than 2 corners, all in the same town and range, may be recorded on this certificate

A. Description of original monument and accessories and/or subsequent restoration:

- 1839: GLO Survey by Lewis Clason: Set post. Referenced: W. Birch 6-N39E-32/W. Pine 11-N51W-64.
- 1906: County Survey by Jos. W. McNeil. One OBT plain, set new cedar stake 3.5" sq. and made NWT. Referenced: W. Pine 11-N51W-64 (OBT)/Sec original.
- 1997: Survey by Daniel T. Kibbe. Found 1/2" Iron rebar on fence line North. Found iron at R.O.W. #27452.
- 1998: Survey by David B. Guthrie. Existing 1/2" rod. Referenced: Fence Corner-S50E-47.12/24" Oak-S20E-143.75/P. Pole-S75W-133.64/5" Spruce-North 54.35'.

B. Description of corner evidence found and/or method applied in restoring or reestablishing corner:

- 1999: Remon. Survey by Daniel T. Kibbe. Found 1/2" rebar 2' South of CL road on fence line North.


This corner position is compatible with county & local surveys. This corner position is accepted as a careful and faithful perpetuation of the position of the original corner.

C. Description of monument for corner and accessories established to perpetuate locating the position of the corner:

- 1999: Placed 3" Alpena County cap stamped to identify the corner over 1/2" iron rod.
 Referenced:
 24" Oak-found tag 22435-S20 E 144.04'
 Fence Corner-found tag 22435-S50 E 47.12'
 P. Pole-found tag 22435-S79 W 133.78'
 5" Spruce-found tag 22435-North 54.28'
 E-1 remon. corner East-56.10'

P.A. 345 ALPENA COUNTY
PEER APPROVED 9/16/99
D.B. [Signature]

Signed by _____
 Surveyor's Michigan License No. 37278

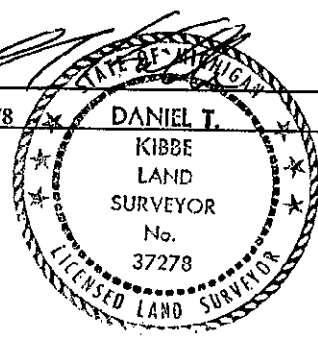

Date November 30, 1999