

**LAND CORNER RECORDATION CERTIFICATE**  
**Filing Requirement of Act 74, Mich. P.A. 1970**

For corners in

<u>Alpena</u> (County)	Located In:	Corner Code #
1. Public Land Survey	T <u>30N</u> R <u>6E</u>	<u>H-13</u>
	T <u>30N</u> R <u>6E</u>	<u>I-13</u>
2. Property Controlling in Section	S _____ T _____ R _____	_____
	S _____ T _____ R _____	_____
3. Miscellaneous Property in Sec.	S _____ T _____ R _____	_____
	S _____ T _____ R _____	_____

Register of Deeds Stamp & File Num

4. Lot No. \_\_\_\_\_, Recorded Plat \_\_\_\_\_

5. Private Claims \_\_\_\_\_

I, Carl T. Kiiskila, in a field survey on Oct. 25, 19 97 do hereby state that under requirements of P.A. 74, Michigan P.A. of 1970, the corner points mentioned in lines 1 and 2 above were in conformance with regulations and rules therefore as required in the current manual of survey instructions of the United States Department of the Interior, Bureau of Land Management or by a decree of a Court of Law and /or that the corner points mentioned in lines 3, 4 and 5 above were in conformance with the rules of the Michigan Board of Land Surveyors or by a Decree of a Court of Law; established, re-established, monumented, recovered, found as expressed below:

A	B	C	D	E	F	G	H	I	J	K	L	M
1												
2	6		5		4		3		2		1	
3												
4	7		8		9		10		11		12	
5												
6	18		17		16		15		14		13	
7												
8	19		20		21		22		23		24	
9												
10	30		29		28		27		26		25	
11												
12	31		32		33		34		35		36	
13												

**NOTE: Not more than 2 corners, all in the same town and range, may be recorded on this certificate.**

**A. Description of original monument and accessories and/or subsequent restoration:**

H-13 GLO set post – Lewis Clawson 1839.  
 Wit: Aspen 4" N 20° E 23 links  
 S. Maple 4" N 55° W 7 links

I-13 GLO set post – Lewis Clawson 1839.  
 Wit: Beech 10" N 54° E 57 links  
 Beech 14" N 28° W 24 links

Page 332, County Survey Notes, Joseph W. McNeil, May 25, 1910 had corner from previous survey.

Page 332, County Survey Notes, Joseph W. McNeil, May 25, 1910 had corner from previous survey.

**B. Description of corner evidence found and/or method applied in restoring or reestablishing corner:**

H-13 Found a 1/2" rod fitting well to J.W. McNeil's 1910 distance east.


I-13 Found a 2" iron pipe fitting well to J.W. McNeil's 1910 distance west.

**C. Description of monument for corner and accessories established to perpetuate locating the position of the corner:**

H-13 Found 1/2" rod.  
 Wit: Power pole S 43° W 39.07'  
 Power pole S 67° E 96.74'  
 Set nail in 12" Red Pine N 66° E 76.91'  
 Set nail in 24" Oak N 36° W 72.97'  
 5/8" reroed with cap East 30.70'  
 Centerline east-west and road north

I-13 Found 2" iron pipe.  
 Wit: Guy pole S 50° E 59.11'  
 Power pole S 52° W 49.39'  
 Wooden fence post N 48° W 62.36'  
 Set nail in 18" Oak N 35° E 94.76'  
 2" iron pipe East 15.29'  
 Centerline north-south and road west

Signed by Carl T Kiiskila  
 Surveyor's Michigan License No. 33981

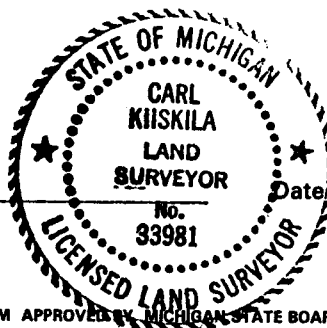

Date 6-14-99