

LAND CORNER RECORDATION CERTIFICATE

Filing Requirement of Act 74, Mich. PA 1970

For Corners In: Alpena (County)	Located In	Corner Code #
1. Public Land Survey	T 30N R 6E	E-12
	T 30N R 6E	F-13
2. Property Controlling in Section	S T R	_____
	S T R	_____
3. Miscellaneous Property in Section	S T R	_____
	S T R	_____


Register of Deeds Stamp & File Number

4. Lot No: _____ Recorded Plat: _____

5. Private Claims: _____

I, Carl T. Kiiskila, in a field survey on November 26, 2001 do hereby state that under requirements of PA 74, Michigan PA of 1970, the corner points mentioned in lines 1 and 2 above were in conformance with regulations and rules therefore as required in the current manual of survey instructions of the United States Department of the Interior, Bureau of Land Management or by a decree of a Court of Law and/or that the corner points mentioned in lines 3, 4 and 5 above were in conformance with the rules of the Michigan Board of Land Surveyors or by a Decree of a Court of Law, established, re-established, monumented, recovered, found as expressed below:

NOTE: Not more than 2 corners, all in the same town and range, may be recorded on this certificate.

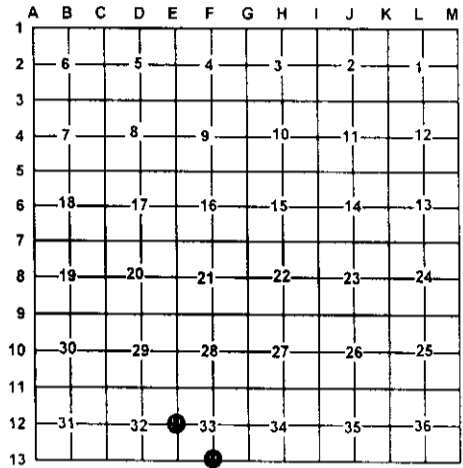

A. Description of original monument and accessories and/or subsequent restoration:

F-13 G.L.O. Lewis Clason 1840
Set quarter section post
Wit: Tamarack 8 N14°E 10 links
Spruce 5 N43°W 6 links

E-12 G.L.O. Lewis Clason D.S. 1840
Marked Cedar 10 inch for quarter section post
Wit: None given

Thomas L. Fabis P.S. #31591 Certificate of Survey,
September 28, 1999. Set 1/2" iron rod at corner fence post.
Wit: 5" Spruce N64°W 33.80'
4" Bam S42°W 20.58'
5" Bam N66°E 10.20'
7" Bam S54°E 11.72'
1" Pipe West 14.41'

B. Description of corner evidence found and/or method applies in restoring or re-establishing corner:

F-13 Reestablished the South quarter corner of section 33
midway and on line between corner E-13 and G-13.

E-12 Found 1/2" capped rod, Thomas Fabis L.S. #31591

C. Description of monument for corner and accessories established to perpetuate locating the position of the corner:

F-13 Set 5/8" X 32" rerod with P. S. Cap #33981
Wit: 5" Spruce S30°E 56.53'
5" Spruce S22°W 53.09'
4" Spruce North 29.08'
5" Cedar N33°W 59.07'
Carsonite post North 33±

E-12 Found 1/2" capped rod Thomas Fabis L.S. #31591
Wit: *6" Poplar S54°E 11.76'
6" Poplar N45°E 23.27'
6" Spruce N54°W 33.60'
*5" Poplar S38°W 20.59'
Old fence North, South and West

* Old witnesses by others

Signed by: Carl T. Kiiskila
Surveyor's Michigan License No.: 33981

Date: 10-29-02

