

LAND CORNER RECORDATION CERTIFICATE


Filing Requirement of Act 74, Mich. PA 1970

For Corners In: Alpena (County)	Located In	Corner Code #
1. Public Land Survey	T 30N R 6E	E-11
	T _____ R _____	_____
2. Property Controlling in Section	S 28 T 30N R 6E	15
	S _____ T _____ R _____	_____
3. Miscellaneous Property in Section	S _____ T _____ R _____	_____
	S _____ T _____ R _____	_____
4. Lot No: _____ Recorded Plat: _____		
5. Private Claims: _____		

Register of Deeds Stamp & File Number

I, Carl T. Kiiskila, in a field survey on November 26, 2001 do hereby state that under equipments of PA 74, Michigan PA of 1970, the corner points mentioned in lines 1 and 2 above were in conformance with regulations and rules therefore as required in the current manual of survey instructions of the United States Department of the Interior, Bureau of Land Management or by a decree of a Court of Law and/or that the corner points mentioned in lines 3, 4 and 5 above were in conformance with the rules of the Michigan Board of Land Surveyors or by a Decree of a Court of Law; established, re-established, monumented, recovered, found as expressed below:

NOTE: Not more than 2 corners, all in the same town and range, may be recorded on this certificate.

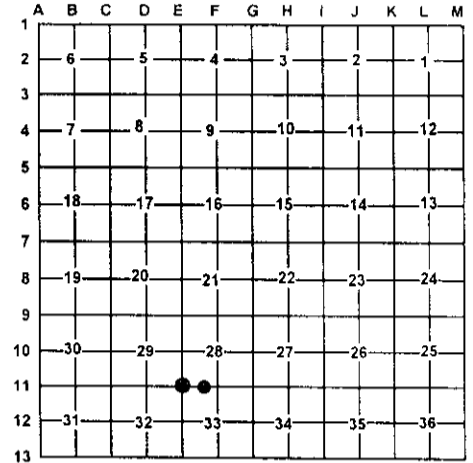

A. Description of original monument and accessories and/or subsequent restoration:

E-11 G.L.O. Lewis Clason D.S. 1840
Set post corner section 28,29,32 and 33
Wit: Cedar 10 S54°W 11 links
Cedar 20 N80° 13 links

15- This corner position was not established during the original government survey.

Thomas L. Fabis P.S. #31591 Cert. of Survey L. 2
Pages 827 & 828 October 22, 1994 Set 1/2" iron rod.
Wit: 5" Balsam N20°W 67.82'
6" Balsam N10°W 57.74'
7" W. Birch N04°W 72.68'
Fence post S70°E 79.75'

B. Description of corner evidence found and/or method applies in restoring or re-establishing corner:

E-11 Found 1/2" rod

15- Established the Southwest corner of the Southeast quarter of the Southwest quarter of section 28 as per B.L.M. instructions for the subdivision of a section.

C. Description of monument for corner and accessories established to perpetuate locating the position of the corner:

E-11 Found 1/2 rod
Wit: *8" White Birch North 72.75'
5" Spruce N10°W 67.88'
*10" Spruce S42°W 118.83'
2" Spruce S70°W 83.23'
Carsonite Post North 33'±

15 Set 5/8" X 32" rered with P.S. cap #33981
Wit: 5" Maple N24°W 55.34'
5" Maple N37°E 39.18'
10" White Pine S45°W 39.99'
7" White Pine S20°E 36.58'
Carsonite Post North 33'±

* Old witnesses by others

Signed by: Carl T. Kiiskila
Surveyor's Michigan License No.: 33981

Date: 10-29-02

