

# LAND CORNER RECORDATION CERTIFICATE

Filing Requirement of Act 74, Mich. PA 1970

For Corners In: Alpena (County)	Located In	Corner Code #
1. Public Land Survey	T <u>30N</u> R <u>6E</u>	<u>E-7</u>
	T _____ R _____	_____
2. Property Controlling in Section	S <u>21</u> T <u>30N</u> R <u>6E</u>	<u>4</u>
	S _____ T _____ R _____	_____
3. Miscellaneous Property in Section	S _____ T _____ R _____	_____
	S _____ T _____ R _____	_____


4. Lot No: \_\_\_\_\_ Recorded Plat: \_\_\_\_\_

5. Private Claims: \_\_\_\_\_

I, Carl T. Kiiskila, in a field survey on November 13, 2001 do hereby state that under requirements of PA 74, Michigan PA of 1970, the corner points mentioned in lines 1 and 2 above were in conformance with regulations and rules therefore as required in the current manual of survey instructions of the United States Department of the Interior, Bureau of Land Management or by a decree of a Court of Law and/or that the corner points mentioned in lines 3, 4 and 5 above were in conformance with the rules of the Michigan Board of Land Surveyors or by a Decree of a Court of Law; established, re-established, monumented, recovered, found as expressed below:

**NOTE: Not more than 2 corners, all in the same town and range, may be recorded on this certificate.**

Register of Deeds Stamp & File Number

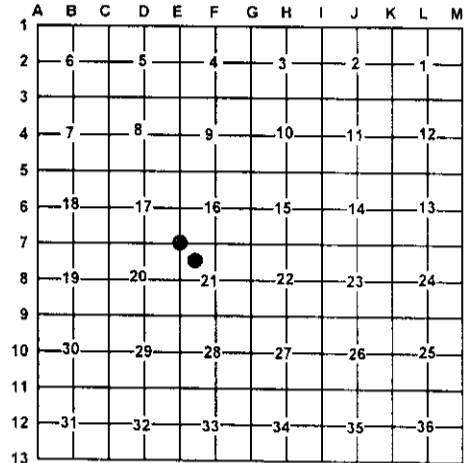

**A. Description of original monument and accessories and/or subsequent restoration:**

E-7 G.L.O. Lewis Clason D.S. 1840  
Set post corner section 16, 17, 20 and 21  
Wit: No witnesses trees convenient

4- Thomas L. Fabis P.S. #31591 Certificate of Survey  
September 28, 2000 shows 1/2" iron rod set.

Thomas L. Fabis P.S. #31591 Certificate of Survey  
September 28, 2000. Existing 1/2" iron rod  
Wit: P. Pole S63°E 69.17'  
Fence Post N20°E 35.19'  
Fence Post S35°E 43.21'  
Fence Post N64°W 84.65'

**B. Description of corner evidence found and/or method applies in restoring or re-establishing corner:**

E-7 Found 1/2" rod

4- Found 1/2" capped rod as set by Thomas L. Fabis L.S. #31591.

**C. Description of monument for corner and accessories established to perpetuate locating the position of the corner:**

E-7 Found 1/2" rod  
Wit: \*Power Pole S63°E 69.09'  
Chisled "X" in concrete headwall N75°W 66.48'  
Chisled "X" in concrete headwall S75°W 65.97'  
\*Fence Post N20E 35.10'

4- Found 1/2" capped rod  
Wit: 5" Balsam S13°W 17.56'  
5" Balsam N78°W 8.58'  
5" Balsam N12°E 12.63'  
10" Tamarack N80°E 18.88'  
Carsonite Post North 1'±

Old witnesses by Thomas L. Fabis #31519

Signed by:

Carl T. Kiiskila

Date:

10-29-02

Surveyor's Michigan License No.:

33981

