

LAND CORNER RECORDATION CERTIFICATE

Filing Requirement of Act 74, Mich. PA 1970

For Corners In: Alpena (County)	Located In	Corner Code #
1. Public Land Survey	T <u>30N</u> R <u>6E</u>	<u>D-3</u>
	T <u>30N</u> R <u>6E</u>	<u>E-3</u>
2. Property Controlling in Section	S _____ T _____ R _____	_____
	S _____ T _____ R _____	_____
3. Miscellaneous Property in Section	S _____ T _____ R _____	_____
	S _____ T _____ R _____	_____


4. Lot No: _____ Recorded Plat: _____

5. Private Claims: _____

I, Carl T. Kiiskila, in a field survey on November 7, 2001 do hereby state that under requirements of PA 74, Michigan PA of 1970, the corner points mentioned in lines 1 and 2 above were in conformance with regulations and rules therefore as required in the current manual of survey instructions of the United States Department of the Interior, Bureau of Land Management or by a decree of a Court of Law and/or that the corner points mentioned in lines 3, 4 and 5 above were in conformance with the rules of the Michigan Board of Land Surveyors or by a Decree of a Court of Law; established, re-established, monumented, recovered, found as expressed below:

NOTE: Not more than 2 corners, all in the same town and range, may be recorded on this certificate.

Register of Deeds Stamp & File Number

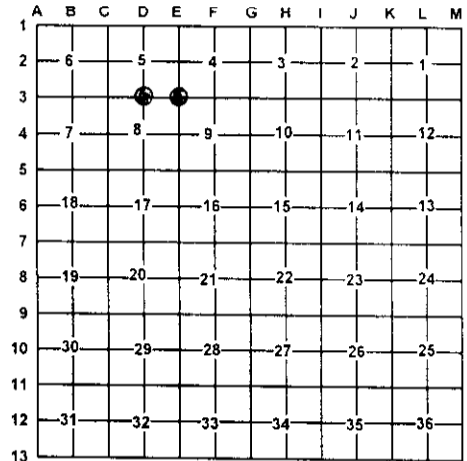

A. Description of original monument and accessories and/or subsequent restoration:

D-3 G.L.O. Lewis Clason D.S. 1840
Set quarter section post
Wit: Tamarack 10" S31°E 39 links
Tamarack 8" N52°W 44 links

E-3 G.L.O. - Lewis Clason D.S. 1840
Set post corner section 4,5,8 and 9
Wit: Tamarack 12 S55°E 7 links
Tamarack 10 N62°W 20 links

David B. Guthrie L.S. #22435 January 1980, L.C.R.C. L. 1,
P. 122. Set 1" iron pin 2646.4 East from the NW section corner
wit: S50°W Power pole 75.33'; N05°E 6" Poplar; N40°E; 6" Poplar
52.75'.

County Surveyor June 8, 1907 corner of sections 4,5,8, and 9.
Cedar stake 3" square in old corduroy
Cedar stump 12" N15°E 73 links O.B.T.
Black Ash stump 10" S65°W 33.5 links O.B.T.
Tamarack 5" N48.5°E 57 links N.W.T.

B. Description of corner evidence found and/or method applies in restoring or re-establishing corner:

D-3 Found 1/2" rod

E-3 Found 1 1/2" pipe

C. Description of monument for corner and accessories established to perpetuate locating the position of the corner:

D-3 Found 1/2" rod
Wit: *Power Pole S07°W 39.64'
*Fence Post N37°W 45.26'
3" Maple Clump N16°E 38.95'
6" Maple Clump N37°E 59.51'
10" Poplar N34°E 52.19'
N-S Fence West 3' ±

E-3 Found 1 1/2" pipe
Wit: Punched hole in C.M.P. N24°E 54.74'
Punched hole in C.M.P. N21°W 53.83'
4" Elm S19°E 53.04'
* Power Pole S49°W 55.61'
Centerline of East-West Road South 3' ±

*Old witnesses by others

* Old witnesses by others

Signed by:

Carl T Kiiskila

Date:

10-29-02

Surveyor's Michigan License No.:

33981

