

JAN 25 2001

2000 Alpena County Remonumentation

LAND CORNER RECORDATION CERTIFICATE
Filing Requirement of Act 74, Mich. P.A. 1970

SECTION

For corners in Alpena

(County)

Located in:

Corner Code #

Barcode area with text: L-2 P-307, 08/14/2000 10:20A, Page: 1 of 1, Kathy J. Mataah, Register Alpena Co., MI LDC 9.00

- 1. Public Land Survey T 30NR 07E E-1
2. Property Controlling in Section S T R
3. Miscellaneous Property in Sec. S T R

Register of Deeds Stamp & File Number

4. Lot No. , Recorded Plat
5. Private Claims

I, Wayne T. Lewis, in a field survey on 2-24-00, 19X do hereby state that under requirements of P.A. 74, Michigan P.A. of 1970, the corner points mentioned in lines 1 and 2 above were in conformance with regulations and rules therefore as required in the current manual of survey instructions of the United States Department of the Interior, Bureau of Land Management or by a decree of a Court of Law and /or that the corner points mentioned in lines 3, 4 and 5 above were in conformance with the rules of the Michigan Board of Land Surveyors or by a Decree of a Court of Law, established, re-established, monumented, recovered, found as expressed below:

NOTE: Not more than 2 corners, all in the same town and range, may be recorded on this certificate.

Grid table with columns A-M and rows 1-13. A dot is marked in the intersection of row 1 and column E.

A. Description of original monument and accessories and/or subsequent restoration:

- 1839: Lewis Clason set post and witnessed.
1891: Fred A. Rice found stake, no witnesses given.
UNKNOWN: Alpena County Road Commission found 1/2" rerod in gravel road, and witnessed.
1971: J. L. Scott, P.S. found 1/2" bar, and recorded survey in Liber 1 of Surveys, page 35, no witnesses given.
1979: R. S. Scott (D. B. Guthrie, P.S.) found 1/2" iron rod, and witnessed.
1983: D. R. MacNeill, P.S. used the corner and recorded survey in Liber 2 of Surveys, page 301, no monumentation or witnesses.
1995: T. L. Fabis, P.S. found 1/2" iron rod w/cap #18660 and recorded survey in Liber 2 of Surveys, page 929, and witnessed.
1997: Wilcox & Assoc. found 1/2" iron w/cap, no witnesses given.

B. Description of corner evidence found and/or method applied in restoring or reestablishing corner:

Found 1/2" rerod w/cap #18660 in intersection of Wallace and King Settlement Roads.

This corner position is accepted as a careful and faithful perpetuation of the position of the original corner.


P.A. 345 ALPENA COUNTY
PEER APPROVED 7-12-2000
D.P.R.

C. Description of monument for corner and accessories established to perpetuate locating the position of the corner:

2000: Placed 3" Alpena County Remonumentation Cap, stamped to identify the corner, on 1/2" rerod driven above existing 1/2" rerod with cap.

Witnesses:

- N 30° E 38.87' Guy Pole (set tag #41922 near exist. disk and nail)
S 30° E 44.00' P. Pole (ex. tag #22435)
S 45° W 74.35' P. Pole (set tag #41922 near ex. disk and nail)
S 55° W 125.20' 15" Spruce (set tag #41922)
N 35° W 46.35' P. Pole (ex. tag #22435)
N 10° W 62.58' SW'ly cor. of conc. blk pillar to porch on House #7998 - 4th blk up

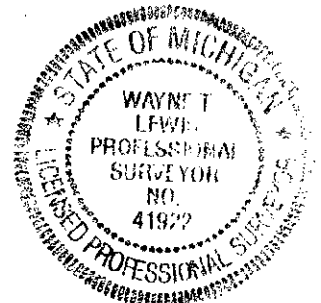

Signed by [Signature]
Surveyor's Michigan License No. 41922

Date August 14, 2000