

JAN 25 2001

2000 Alpena County Remonumentation

LAND CORNER RECORDATION CERTIFICATE  
Filing Requirement of Act 74, Mich. P.A. 1970

SECTION

For corners in

Alpena

(County)

Located in:

Corner Code #



L-2 P-306

08/14/2000 10:20A  
Page: 1 of 1

Kathy J. Matash, Register Alpena Co., MI LDC 8.00

- 1. Public Land Survey      T 30NR 07E      E-2  
    T \_\_\_ R \_\_\_      \_\_\_\_\_  
    T \_\_\_ R \_\_\_      \_\_\_\_\_  
    T \_\_\_ R \_\_\_      \_\_\_\_\_
- 2. Property Controlling    S \_\_\_ T \_\_\_ R \_\_\_      \_\_\_\_\_  
    In Section                S \_\_\_ T \_\_\_ R \_\_\_      \_\_\_\_\_
- 3. Miscellaneous            S \_\_\_ T \_\_\_ R \_\_\_      \_\_\_\_\_  
    Property in Sec.         S \_\_\_ T \_\_\_ R \_\_\_      \_\_\_\_\_

Register of Deeds Stamp & File Number

- 4. Lot No. \_\_\_\_\_, Recorded Plat \_\_\_\_\_
- 5. Private Claims \_\_\_\_\_

I, Wayne T. Lewis, in a field survey on 2-24-00, ~~XX~~ do hereby state that under requirements of P.A. 74, Michigan P.A. of 1970, the corner points mentioned in lines 1 and 2 above were in conformance with regulations and rules therefore as required in the current manual of survey instructions of the United States Department of the Interior, Bureau of Land Management or by a decree of a Court of Law and /or that the corner points mentioned in lines 3, 4 and 5 above were in conformance with the rules of the Michigan Board of Land Surveyors or by a Decree of a Court of Law, established, re-established, monumented, recovered, found as expressed below:

NOTE: Not more than 2 corners, all in the same town and range, may be recorded on this certificate.

	A	B	C	D	E	F	G	H	I	J	K	L	M
1													
2	6			5	●	4		3		2		1	
3													
4	7			8		9		10		11		12	
5													
6	18			17		16		15		14		13	
7													
8	19			20		21		22		23		24	
9													
10	30			29		28		27		26		25	
11													
12	31			32		33		34		35		36	
13													

A. Description of original monument and accessories and/or subsequent restoration:

- 1839: Lewis Clason set post and witnessed.
- 1891: Fred A. Rice set stake, no witnesses given.
- UNKNOWN: Alpena County Road Commission found 1/2" rerod in pav't, no witnesses given.
- 1995: T. L. Fabis, P.S. set 1/2" iron rod w/cap #31591, single proportion w/county surveyor's notes and recorded survey in Liber 2 of Surveys, page 929, no witnesses given.
- 1997: Wilcox & Assoc. found 1/2" iron 2' W'y of N/S C/L, no witnesses given.
- 1998: Lewis & Lewis (W. T. Lewis, P.S.) found 1/2" rerod and recorded survey in Liber 3 of Surveys, page 169, no witnesses given.

B. Description of corner evidence found and/or method applied in restoring or reestablishing corner:

Found 1/2" rerod 2.4' West of N/S C/L.

This corner position is accepted as a careful and faithful perpetuation of the position of the original corner.


P.A. 345 ALPENA COUNTY  
PEER APPROVED 7-12-2000  
D.D.B. Lt

C. Description of monument for corner and accessories established to perpetuate locating the position of the corner:

2000: Placed 3" Alpena County Remonumentation Cap, stamped to identify the corner on existing 1/2" rerod.

Witnesses:

- S 20° W 146.66' P. Pole (set tag #41922)
- West 54.89' 5" Birch (set tag #41922)
- N 65° W 38.89' 13" Apple (set tag #41922 in S'y tree of cluster)
- North 211.42' P. Pole (set tag #41922)

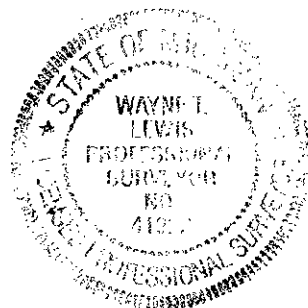

Signed by [Signature]  
Surveyor's Michigan License No. 41922

Date August 14, 2000