

JAN 25 2001

2000 Alpena County Remonumentation

SECTION

LAND CORNER RECORDATION CERTIFICATE
Filing Requirement of Act 74, Mich. P.A. 1970

For corners in
Alpena
(County)

Located in:

Corner Code #



L-2 P-304
08/14/2000 10:20A
Page: 1 of 1
LDC 9.00


- 1. Public Land Survey T 30NR 07E E-4
- T R
- T R
- T R
- 2. Property Controlling S T R
- in Section S T R
- 3. Miscellaneous S T R
- Property in Sec. S T R

Register of Deeds Stamp & File Number

- 4. Lot No. _____, Recorded Plat _____
- 5. Private Claims _____

I, Wayne T. Lewis, in a field survey on 2-24-00, ~~19~~ do hereby state that under requirements of P.A. 74, Michigan P.A. of 1970, the corner points mentioned in lines 1 and 2 above were in conformance with regulations and rules therefore as required in the current manual of survey instructions of the United States Department of the Interior, Bureau of Land Management or by a decree of a Court of Law and/or that the corner points mentioned in lines 3, 4 and 5 above were in conformance with the rules of the Michigan Board of Land Surveyors or by a Decree of a Court of Law; established, re-established, monumented, recovered, found as expressed below:

NOTE: Not more than 2 corners, all in the same town and range, may be recorded on this certificate.

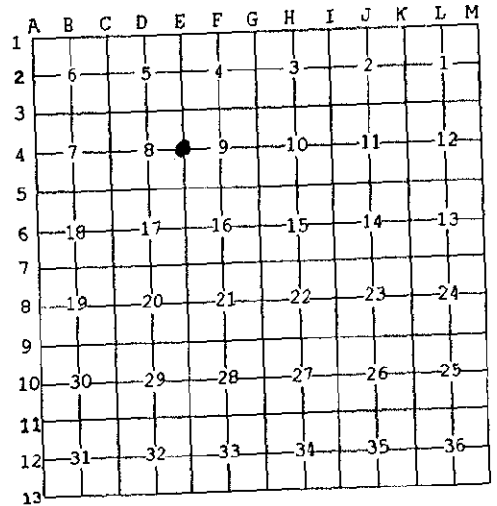

A. Description of original monument and accessories and/or subsequent restoration:

- 1839: Lewis Clason set post and witnessed.
- 1910: J. W. McNeil set long stone w/crock pieces, used GLO call to stream, S of corner, and road to the West.
- 1974: Feldhauser Assoc. (Edward LaCross, P.S.) set iron and witnessed.
- 1980: R. S. Scott Assoc. (D.B. Guthrie, P.S.) found 1/2" iron and witnessed.
- 1989: Earl T. Lewis, P.S. found 1/2" rod and recorded survey in Liber 2 of Surveys, page 743 and witnessed.
- 1997: Wilcox & Assoc. found 1/2" rebar in intersection, no witnesses given.
- 1995 and 1998: T. L. Fabis, P.S. found 1/2" iron rod, and witnessed (1995 field notes).

B. Description of corner evidence found and/or method applied in restoring or reestablishing corner:

Found 1/2" rerod in intersection of King Settlement Road and Zbytowski Road, and 9' North of fence to the East.

This corner position is accepted as a careful and faithful perpetuation of the position of the original corner.


P.A. 345 ALPENA COUNTY
PEER APPROVED 7-12-2000
W.T.L.

C. Description of monument for corner and accessories established to perpetuate locating the position of the corner:

2000: Placed 3" Alpena County Remonumentation Cap, stamped to identify the corner, on existing 1/2" rerod in monument box.

Witnesses:

- N 40° E 82.91' 14" Cedar (set tag #41922)
- N 55° E 40.69' P. Pole (set tag #41922 over nail w/ribbon)
- S 40° E 43.51' P. Pole (set tag #41922 over nail w/ribbon)
- S 65° W 55.50' P. Pole (set tag #41922)
- N 30° W 65.36' Wood Fence Post (ex. tag #31591)

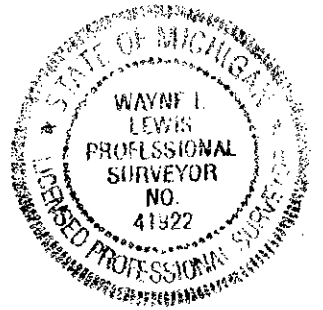

Signed by [Signature]
Surveyor's Michigan License No. 41922

Date August 14, 2000