

JAN 25 2001

2000 Alpena County Remonumentation

LAND CORNER RECORDATION CERTIFICATE
Filing Requirement of Act 74, Mich. P.A. 1970

SECTION

For corners in
Alpena

(County)

Located In:

Corner Code #



L- 2 P- 317
08/14/2000 10:20
Page: 1 of 1
Kathy J. Matash, Register Alpena Co., MI LDC 9.00

- 1. Public Land Survey T 30NR 07E E-5
- T ___ R _____
- T ___ R _____
- T ___ R _____
- 2. Property Controlling S ___ T ___ R _____
- in Section S ___ T ___ R _____
- 3. Miscellaneous S ___ T ___ R _____
- Property in Sec. S ___ T ___ R _____

Register of Deeds Stamp & File Number

- 4. Lot No. _____, Recorded Plat _____
- 5. Private Claims _____

I, Wayne T. Lewis, in a field survey on 2-24-00, ~~19~~²⁰X do hereby state that under requirements of P.A. 74, Michigan P.A. of 1970, the corner points mentioned in lines 1 and 2 above were in conformance with regulations and rules therefore as required in the current manual of survey instructions of the United States Department of the Interior, Bureau of Land Management or by a decree of a Court of Law and /or that the corner points mentioned in lines 3, 4 and 5 above were in conformance with the rules of the Michigan Board of Land Surveyors or by a Decree of a Court of Law; established, re-established, monumented, recovered, found as expressed below:

	A	B	C	D	E	F	G	H	I	J	K	L	M
1													
2	6		5		4		3		2		1		
3													
4	7		8		9		10		11		12		
5													
6	10		17		16		15		14		13		
7													
8	19		20		21		22		23		24		
9													
10	30		29		28		27		26		25		
11													
12	31		32		33		34		35		36		
13													

NOTE: Not more than 2 corners, all in the same town and range, may be recorded on this certificate.

A. Description of original monument and accessories and/or subsequent restoration:

- 1839: Lewis Clason set post and witnessed.
- 1888: W. H. LeRoy found corner, no monumentation or witnesses given.
- 1894: W. H. LeRoy found old stake and witnessed.
- 1910: J. W. McNeil found large stake in center of cross roads, no witnesses given.
- 1979: D. R. MacNeill, P.S. set 1" pipe, no witnesses given.
- 1980: R. S. Scott (D. B. Guthrie, P.S.) found 1" pipe, and witnessed.
- 1997: Lewis & Lewis (W. T. Lewis, P.S.) found PK nail, and witnessed.
- 1997: Wilcox & Assoc. found PK nail, 1' West of C/L, and D. R. MacNeill pipe, 11' West of C/L, no witnesses given.

B. Description of corner evidence found and/or method applied in restoring or reestablishing corner:

Found PK in intersection of King Settlement Road and Napper Road.

This corner position is accepted as a careful and faithful perpetuation of the position of the original corner.


P.A. 345 ALPENA COUNTY
PEER APPROVED 7-12-2000
D.A.L.

C. Description of monument for corner and accessories established to perpetuate locating the position of the corner:

2000: Placed 3" Alpena County Remonumentation Cap, stamped to identify the corner, on 1/2" rerod in monument box in place of p.k. nail.

Witnesses:

- N 60° E 56.19' Guy Pole (set tag #41922)
- S 50° E 51.48' Guy Pole (ex. tag # 41922)
- S 70° W 58.16' Cable Pole (ex. tag #41922)
- N 50° W 61.00' P. Pole (set tag #41922)
- West 9.99' 1-1/4" pipe w/cap unidentifiable

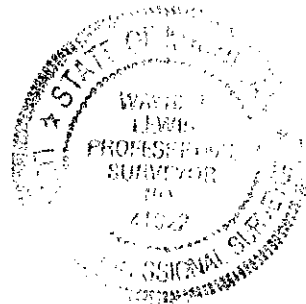

Signed by

Wayne T. Lewis

Date August 14, 2000

Surveyor's Michigan License No.

41922