

JAN 25 2001

2000 Alpena County Remonumentation

LAND CORNER RECORDATION CERTIFICATE
Filing Requirement of Act 74, Mich. P.A. 1970

SECTION

For corners in
Alpena

(County)

Located In:

Corner Code #



L- 2 P- 314
08/14/2000 10:20A
Page: 1 of 1
Kathy J. Matash, Register Alpena Co., MI LDC 9.00

- 1. Public Land Survey T 30N R 07E E-8
- T R
- T R
- T R
- 2. Property Controlling S T R
- in Section S T R
- 3. Miscellaneous S T R
- Property in Sec. S T R

Register of Deeds Stamp & File Number

- 4. Lot No. _____, Recorded Plat _____
- 5. Private Claims _____

I, Wayne T. Lewis, in a field survey on 2-24-00, XX do hereby state that under requirements of P.A. 74, Michigan P.A. of 1970, the corner points mentioned in lines 1 and 2 above were in conformance with regulations and rules therefore as required in the current manual of survey instructions of the United States Department of the Interior, Bureau of Land Management or by a decree of a Court of Law and/or that the corner points mentioned in lines 3, 4 and 5 above were in conformance with the rules of the Michigan Board of Land Surveyors or by a Decree of a Court of Law; established, re-established, monumented, recovered, found as expressed below:

NOTE: Not more than 2 corners, all in the same town and range, may be recorded on this certificate.

	A	B	C	D	E	F	G	H	I	J	K	L	M	
1														
2	6			5			4			3			2	1
3														
4	7			8			9			10			11	12
5														
6	10			17			16			15			14	13
7														
8	19			20			21			22			23	24
9														
10	30			29			28			27			26	25
11														
12	31			32			33			34			35	36
13														


- A. Description of original monument and accessories and/or subsequent restoration:
- 1839: Lewis Clason set post and witnessed.
 - 1888: W. H. LeRoy found corner, no monumentation or witnesses given.
 - 1901: J. W. McNeil set stake w/stone using property owners' testimony for location, no witnesses given.
 - 1907: J. W. McNeil found stake previously set by him, no witnesses given.
 - UNKNOWN: Alpena County Road Commission found 3/4" pipe in mon. box, and witnessed.
 - 1995: Lewis & Lewis (E. T. Lewis, P.S.) found 1" pipe in mon. box and witnessed.
 - 1998: T. L. Fabis, P.S. found mon. box and witnessed.

- B. Description of corner evidence found and/or method applied in restoring or reestablishing corner:
- Found 1-1/4" pipe in monument Box 4' South of Werth Road C/L and 4' West of King Settlement Road C/L.
- This corner position is accepted as a careful and faithful perpetuation of the position of the original corner.

P.A. 345 ALPENA COUNTY
PEER APPROVED 7-12-2000
D.D.B. C

- C. Description of monument for corner and accessories established to perpetuate locating the position of the corner:
- 2000: Placed 3" Alpena County Remonumentation Cap, stamped to identify the corner, on 1/2" rered driven inside existing pipe.

- Witnesses:
- N 40° E 66.38' Guy Pole (ex. tag #31591)
 - S 35° E 58.01' Power Pole (set tag #41922 over disk and nail)
 - S 40° W 52.38' P. Pole (set tag #41922 over disk and nail)
 - N 20° W 62.03' P. Pole (set tag #41922 over disk and nail)

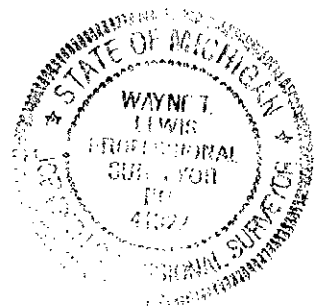

Signed by *Wayne T. Lewis*
Surveyor's Michigan License No. 41922

Date August 14, 2000