

JAN 25 2001

2000 Alpena County Remonumentation

LAND CORNER RECORDATION CERTIFICATE  
Filing Requirement of Act 74, Mich. P.A. 1970

SECTION

For corners in

Alpena

(County)

Located in:

Corner Code #

L-2 P-312  
08/14/2000 10:20  
Page: 1 of 1  
Kathy J. Matash, Register Alpena Co., MI LDC 9.00

- |                                    |              |                           |             |
|------------------------------------|--------------|---------------------------|-------------|
| 1. Public Land Survey              |              | T <u>30NR 07E</u>         | <u>E-10</u> |
|                                    |              | T <u>   </u> R <u>   </u> | <u>   </u>  |
|                                    |              | T <u>   </u> R <u>   </u> | <u>   </u>  |
|                                    |              | T <u>   </u> R <u>   </u> | <u>   </u>  |
| 2. Property Controlling in Section | S <u>   </u> | T <u>   </u> R <u>   </u> | <u>   </u>  |
|                                    | S <u>   </u> | T <u>   </u> R <u>   </u> | <u>   </u>  |
| 3. Miscellaneous Property in Sec.  | S <u>   </u> | T <u>   </u> R <u>   </u> | <u>   </u>  |
|                                    | S <u>   </u> | T <u>   </u> R <u>   </u> | <u>   </u>  |

Register of Deeds Stamp & File Number

4. Lot No. \_\_\_\_\_, Recorded Plat \_\_\_\_\_  
5. Private Claims \_\_\_\_\_

I, Wayne T. Lewis, in a field survey on 2-24-00, ~~19~~<sup>19</sup>X do hereby state that under requirements of P.A. 74, Michigan P.A. of 1970, the corner points mentioned in lines 1 and 2 above were in conformance with regulations and rules therefore as required in the current manual of survey instructions of the United States Department of the Interior, Bureau of Land Management or by a decree of a Court of Law and/or that the corner points mentioned in lines 3, 4 and 5 above were in conformance with the rules of the Michigan Board of Land Surveyors or by a Decree of a Court of Law, established, re-established, monumented, recovered, found as expressed below:

NOTE: Not more than 2 corners, all in the same town and range, may be recorded on this certificate.

	A	B	C	D	E	F	G	H	I	J	K	L	M
1													
2	6		5		4		3		2		1		
3													
4	7		8		9		10		11		12		
5													
6	18		17		16		15		14		13		
7													
8	19		20		21		22		23		24		
9													
10	30		29		28		27		26		25		
11													
12	31		32		33		34		35		36		
13													


A. Description of original monument and accessories and/or subsequent restoration:  
1839: Lewis Clason set post and witnessed.  
1901: J. W. McNeil set large cedar stake in center of road, no witnesses given.

B. Description of corner evidence found and/or method applied in restoring or reestablishing corner:  
Found large spike at surface, found 1/2" rod 14" below surface, set new 1/2" rod at base, 1.2' West of King Settlement Road C/L.  
This corner position is accepted as a careful and faithful perpetuation of the position of the original corner.

P.A. 345 ALPENA COUNTY  
PEER APPROVED 7-12-2000  
D.P.B. W

C. Description of monument for corner and accessories established to perpetuate locating the position of the corner:  
2000: Placed 3" Alpena County Remonumentation Cap, stamped to identify the corner, on 1/2" rod.

- Witnesses:
- N 30° E 58.46' 5" Apple (set tag #41922)
  - S 85° E 26.43' S'y end of steel culvert (sawed "V" in top center of pipe)
  - S 15° E 380.88' NW'y corner of stone foundation, House #7545
  - N 85° W 40.30' Old Wood Fence Post (set tag #41922 over Alum. disk w/nail reading 505 BM Elev.)
  - N 85° W 58.31' P. Pole (set tag #41922)

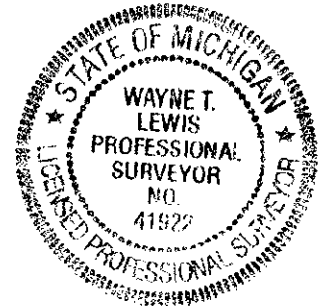

Signed by [Signature]  
Surveyor's Michigan License No. 41922

Date August 14, 2000