

JAN 25 2001

2000 Alpena County Remonumentation

SECTION

LAND CORNER RECORDATION CERTIFICATE  
Filing Requirement of Act 74, Mich. P.A. 1970

For corners in  
Alpena

(County)

Located In:

Corner Code #



L- 2 P- 309  
08/14/2000 10:20A  
Page: 1 of 1  
Kathy J. Matash, Register Alpena Co., MI LDC 9.00

- 1. Public Land Survey      T 30NR 07E      F-5
- T      R      \_\_\_\_\_
- T      R      \_\_\_\_\_
- T      R      \_\_\_\_\_
- T      R      \_\_\_\_\_
- 2. Property Controlling    S      T      R      \_\_\_\_\_
- in Section                S      T      R      \_\_\_\_\_
- 3. Miscellaneous           S      T      R      \_\_\_\_\_
- Property in Sec.        S      T      R      \_\_\_\_\_

Register of Deeds Stamp & File Number

- 4. Lot No. \_\_\_\_\_, Recorded Plat \_\_\_\_\_
- 5. Private Claims \_\_\_\_\_

I, Wayne T. Lewis, in a field survey on 2-24-00, 19<sup>XX</sup> do hereby state that under requirements of P.A. 74, Michigan P.A. of 1970, the corner points mentioned in lines 1 and 2 above were in conformance with regulations and rules therefore as required in the current manual of survey instructions of the United States Department of the Interior, Bureau of Land Management or by a decree of a Court of Law and /or that the corner points mentioned in lines 3, 4 and 5 above were in conformance with the rules of the Michigan Board of Land Surveyors or by a Decree of a Court of Law; established, re-established, monumented, recovered, found as expressed below:

A	B	C	D	E	F	G	H	I	J	K	L	M
1												
2	6		5		4		3		2		1	
3												
4	7		8		9		10		11		12	
5					●							
6	18		17		16		15		14		13	
7												
8	19		20		21		22		23		24	
9												
10	30		29		28		27		26		25	
11												
12	31		32		33		34		35		36	
13												

NOTE: Not more than 2 corners, all in the same town and range, may be recorded on this certificate.

A. Description of original monument and accessories and/or subsequent restoration:

- 1839: Lewis Clason set post and witnessed.
- 1894: Fred A. Rice set 3" cedar stake in place of old stake, found original bearing trees.
- 1910: J. W. McNeil found large stake, no witnesses given.
- 1971: J. L. Scott, P.S. recorded survey in Liber 1 of Surveys, page 8, notes corner as approximate corner, no monumentation or witnesses given.
- 1997: Wilcox & Assoc. found 1/2" iron at North ROW, no corner found in road.

B. Description of corner evidence found and/or method applied in restoring or reestablishing corner:

Set 1/2" rerod, 33' South of West line of R.S. Scott survey, as recorded in Liber 1 of Surveys, page 8, Alpena County Records. Corner falls in centerline of Napper Road and is compatible with County Surveyor's notes.

This corner position is accepted as a careful and faithful perpetuation of the position of the original corner.


PA. 345 ALPENA COUNTY  
PEER APPROVED 7-12-2000  
DORC

C. Description of monument for corner and accessories established to perpetuate locating the position of the corner:

2000: Placed 3" Alpena County Remonumentation Cap, stamped to identify the corner, on 1/2" rerod.

Witnesses:

- North 33.00' Exist. 1/2" Rerod
- N 45° E 50.56' Telephone Pole (set tag #41922)
- S 30° E 32.35' 24" Maple (set tag #41922)
- N 15° E 22.00' 18" Maple (set tag #41922)

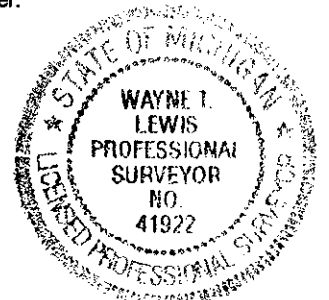

Signed by [Signature]  
Surveyor's Michigan License No. 41922

Date August 14, 2000