

JAN 25 2001

2000 Alpena County Remonumentation

LAND CORNER RECORDATION CERTIFICATE
Filing Requirement of Act 74, Mich. P.A. 1970

SECTION

For corners in
Alpena

(County)

Located In:

Corner Code #



L- 2 P- 308

08/14/2000 10:20A

Page: 1 of 1

Kathy J. Mataah, Register Alpena Co., MI LDC 9.00

- 1. Public Land Survey T 30NR 07E G-5
- T R
- T R
- T R
- T R
- 2. Property Controlling S T R
- in Section S T R
- 3. Miscellaneous S T R
- Property in Sec. S T R

Register of Deeds Stamp & File Number

- 4. Lot No. _____, Recorded Plat _____
- 5. Private Claims _____

I, Wayne T. Lewis, in a field survey on 2-24-00, ~~19~~^{XX} do hereby state that under requirements of P.A. 74, Michigan P.A. of 1970, the corner points mentioned in lines 1 and 2 above were in conformance with regulations and rules therefore as required in the current manual of survey instructions of the United States Department of the Interior, Bureau of Land Management or by a decree of a Court of Law and /or that the corner points mentioned in lines 3, 4 and 5 above were in conformance with the rules of the Michigan Board of Land Surveyors or by a Decree of a Court of Law, established, re-established, monumented, recovered, found as expressed below:

NOTE: Not more than 2 corners, all in the same town and range, may be recorded on this certificate.

| | | | | | | | | | | | | | |
|----|----|---|----|---|----|---|----|---|----|---|----|---|---|
| | A | B | C | D | E | F | G | H | I | J | K | L | M |
| 1 | | | | | | | | | | | | | |
| 2 | 6 | | 5 | | 4 | | 3 | | 2 | | 1 | | |
| 3 | | | | | | | | | | | | | |
| 4 | 7 | | 8 | | 9 | | 10 | | 11 | | 12 | | |
| 5 | | | | | | | ● | | | | | | |
| 6 | 18 | | 17 | | 16 | | 15 | | 14 | | 13 | | |
| 7 | | | | | | | | | | | | | |
| 8 | 19 | | 20 | | 21 | | 22 | | 23 | | 24 | | |
| 9 | | | | | | | | | | | | | |
| 10 | 30 | | 29 | | 28 | | 27 | | 26 | | 25 | | |
| 11 | | | | | | | | | | | | | |
| 12 | 31 | | 32 | | 33 | | 34 | | 35 | | 36 | | |
| 13 | | | | | | | | | | | | | |

A. Description of original monument and accessories and/or subsequent restoration:

- 1839: Lewis Clason set post and witnessed.
- 1894: Fred A. Rice set 4" cedar stake, found original bearing trees and added one new witness.
- 1910: J. W. McNeil set new stake in place of old stake, no witnesses given.
- 1973: R. S. Scott Assoc. (J. L. Scott, P.S. and D. E. Marlatt, P.S.) set 1/2" rerod in line with fence to the South and recorded survey (L 1, P 216) and LCRC (L 1, P 33) and witnessed.
- 1997: Wilcox & Assoc. found bent over rebar, 8' South of road C/L, no witnesses given.

B. Description of corner evidence found and/or method applied in restoring or reestablishing corner:

Found 1/2" rerod bent S'ly, set new 1/2" rerod where straight, 0.6' below surface, 6.5' South of Napper Road, 3' East of old downed fence to the South, 3' East of power line.

This corner position is accepted as a careful and faithful perpetuation of the position of the original corner.


P.A. 345 ALPENA COUNTY
PEER APPROVED 7-12-2000
D. B. [Signature]

C. Description of monument for corner and accessories established to perpetuate locating the position of the corner:

2000: Placed 3" Alpena County Remonumentation Cap, stamped to identify the corner, on 1/2" rerod.

Witnesses:

- N 10° E 43.00' P. Pole (set tag #41922)
- S 15° W 34.20' P. Pole (set tag #41922)
- S 65° W 67.44' 10" Maple (set tag #31591)
- N 60° W 103.92' P. Pole (set tag #41922)

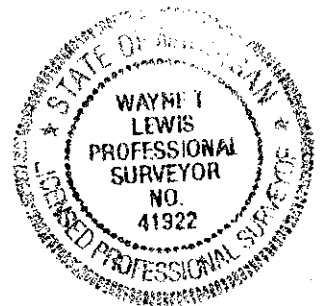

Signed by *[Signature]*
Surveyor's Michigan License No. 41922

Date August 14, 2000