

SURVEY & REMONUMENTATION 1994 ALPENA COUNTY REMONUMENTATION CORNER

007643

RECORDED ALPENA COUNTY MI.

LIRFR 1 PAGE 352
Dec 29 2 21 PM '94

Dominic A. Johnston
REGISTER OF DEEDS

Register of Deeds Stamp & File Number

LAND CORNER RECORDATION CERTIFICATE
Filing Requirement of Act 74, Mich. P.A. 1970

For corners in

Alpena
(County)

APR 06 1995

COMMISSION


Located In:

Corner Code #

1. Public Land Survey	T	30N	R	7E	G-9
	T		R		
	T		R		
	T		R		
2. Property Controlling in Section	S		T	R	
	S		T	R	
3. Miscellaneous Property in Sec.	S		T	R	
	S		T	R	

4. Lot No. _____, Recorded Plat _____
5. Private Claims _____

Duane R. MacNeill, in a field survey on May 23, 1994,
do hereby certify that under requirements of P.A. 74, Michigan P.A. of 1970, the corner points mentioned
in lines 1 and 2 above were in conformance with regulations and rules therefore as required in the
current manual of survey instructions of the United States Department of the Interior, Bureau of Land
Management or by a decree of a Court of Law and/or that the corner points mentioned in lines 3, 4 and 5
above were in conformance with the rules of the Michigan Board of Land Surveyors or by a Decree of a
Court of Law; established, re-established, monumented, re-monumented, recovered, found as
expressed below:

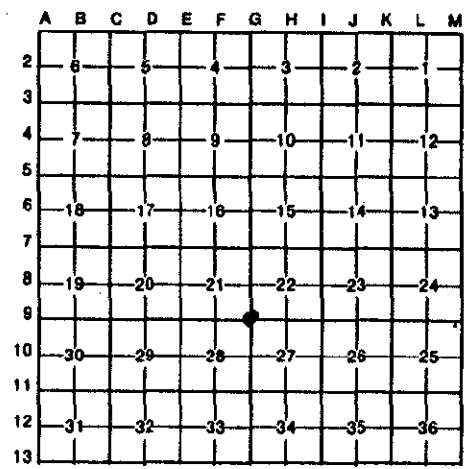

NOTE: Not more than 4 corners, all in the same town and range, may be recorded on this certificate.

Description of original monument and accessories and/or subsequent restoration:

1839 - Cedar Post set by Thad Pattison, D.S.	1897 - William H. Leroy was into corner but did not identify what he found, however, claims to have found one witness tree.	1982 - Corner recorded by Gary St. Charles, Alpena County Road Comm. Surveyor found concrete monument (unknown origin) after Road construction complete, raised with 1/2" re-rod.
Witnesses: Hem 18" N37°E 32 Cedar 12" S22°W 27	<u>No Witnesses Supplied</u>	Witnesses: NE 46.88 P.P. NW 90.82 S.E. corner house.

Description of corner evidence found and/or method applied in restoring or reestablishing corner:


1984 - D.R. MacNeill & Associates find 1/2" re-rod in monument box.	1993 - D.R. MacNeill & Associates find 1/2" re-rod in monument box.
<u>No Witnesses Supplied</u>	<u>No Witnesses Supplied</u>

P.A. 345 ALPENA COUNTY
PEER APPROVED 12/15/94
D. B. Little

Description of monument for corner and accessories established to perpetuate locating the position of the corner:

1994 Remonumentation Crew found 1/2" re-rod in Monument box. An Alpena County Aluminum Remonumentation Cap, appropriately stamped, was secured to the existing 1/2" re-rod.

Witnesses:
N35°W 90.81 SE corner house.
N55°E 53.73 P.P.
N50°W 63.21 P.P.
S80°E 81.55 8" Apple

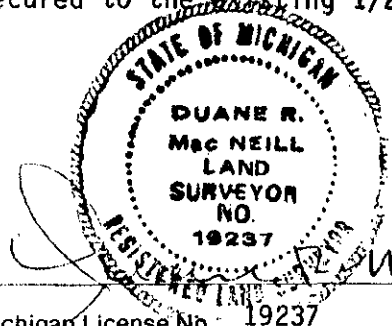

Witnessed by *Duane R. MacNeill* Date 12/28/94
Surveyor's Michigan License No. 19237