


LAND CORNER RECORDATION CERTIFICATE
Filing Requirement of Act 74, Mich. P.A. 1970

For corners in

<u>Alpena</u> (County)	Located In:	Corner Code #
1. Public Land Survey	T _____ R _____	_____
	T _____ R _____	_____
2. Property Controlling in Section	S <u>2</u> T <u>30N</u> R <u>7E</u>	<u>4</u>
	S <u>2</u> T <u>30N</u> R <u>7E</u>	<u>14</u>
3. Miscellaneous Property in Sec.	S _____ T _____ R _____	_____
	S _____ T _____ R _____	_____

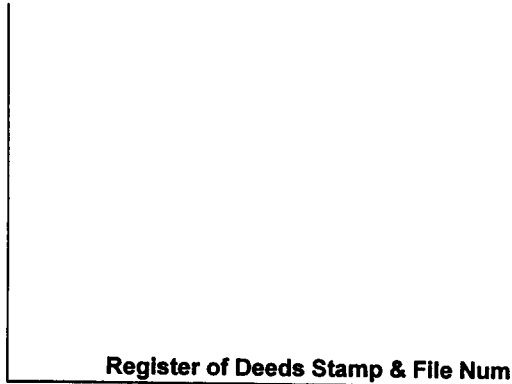

4. Lot No. _____, Recorded Plat _____

5. Private Claims _____

I, Carl T. Kiiskila, in a field survey on June 23, 19 99 do hereby state that under requirements of P.A. 74, Michigan P.A. of 1970, the corner points mentioned in lines 1 and 2 above were in conformance with regulations and rules therefore as required in the current manual of survey instructions of the United States Department of the Interior, Bureau of Land Management or by a decree of a Court of Law and /or that the corner points mentioned in lines 3, 4 and 5 above were in conformance with the rules of the Michigan Board of Land Surveyors or by a Decree of a Court of Law; established, re-established, monumented, recovered, found as expressed below:

	A	B	C	D	E	F	G	H	I	J	K	L	M
1													
2	6		5		4		3			2		1	
3													
4	7		8		9		10		11		12		
5													
6	18		17		16		15		14		13		
7													
8	19		20		21		22		23		24		
9													
10	30		29		28		27		26		25		
11													
12	31		32		33		34		35		36		
13													

NOTE: Not more than 2 corners, all in the same town and range, may be recorded on this certificate.

A. Description of original monument and accessories and/or subsequent restoration:

- 4 - This corner position was not established during the original government survey.
- 14 - This corner position was not established during the original government survey.

B. Description of corner evidence found and/or method applied in restoring or reestablishing corner:

- 4 - Established the Northwest corner of the Southeast quarter of the Northwest quarter of Section 2 per standard B.L.M. instructions for subdivision of a section.
- 14 - Found and accepted a 1-1/4" iron pipe set by Marcus Schaaf, RLS # 3104, c. 1940.

C. Description of monument for corner and accessories established to perpetuate locating the position of the corner:

- | | |
|---|---|
| 4 - Set a 5/8" x 32" rod with PS cap and carsonite marker post. | 14 - Found 1-1/4" iron pipe. Set carsonite marker post. |
| Wit: Set nail in 12" Oak S 59° W 6.83' | Wit: Set nail in 6" triple Maple S 80° W 29.33' |
| Set nail in 22" Red Pine N 40° W 35.60' | Set nail in 3" Spruce N 15° W 24.98' |
| Set nail in 8" & 10" twin Oak N 50° E 46.03' | Set nail in 2" Maple N 44° E 39.56' |
| Set nail in 18" Oak S 82° E 25.65' | Set nail in 3" Spruce S 8° E 52.01' |
| Concrete plat monument N 7° E 5.06' | Centerline north-south |
| Centerline north-south trail road East 4' | trail road East 1' |
| Carsonite post N 82° E 17.2' | Carsonite post East 20' |

Signed by Carl T Kiiskila
 Surveyor's Michigan License No. 33981



Date 8-12-99