

LAND CORNER RECORDATION CERTIFICATE
Filing Requirement of Act 74, Mich. P.A. 1970

For corners in

| | | |
|---------------------------------------|-------------------------|---------------|
| <u>Alpena</u> (County) | Located In: | Corner Code # |
| 1. Public Land Survey | T 30N R 7E | I-2 |
| | T 30N R 7E | I-3 |
| 2. Property Controlling in Section | S _____ T _____ R _____ | _____ |
| | S _____ T _____ R _____ | _____ |
| 3. Miscellaneous Property in Sec. | S _____ T _____ R _____ | _____ |
| | S _____ T _____ R _____ | _____ |

Register of Deeds Stamp & File Num

4. Lot No. _____, Recorded Plat _____

5. Private Claims _____

I, Carl T. Kiiskila, in a field survey on June 21, 19 99 do hereby state that under requirements of P.A. 74, Michigan P.A. of 1970, the corner points mentioned in lines 1 and 2 above were in conformance with regulations and rules therefore as required in the current manual of survey instructions of the United States Department of the Interior, Bureau of Land Management or by a decree of a Court of Law and /or that the corner points mentioned in lines 3, 4 and 5 above were in conformance with the rules of the Michigan Board of Land Surveyors or by a Decree of a Court of Law; established, re-established, monumented, recovered, found as expressed below:

| | | | | | | | | | | | | | |
|----|---|----|---|----|---|----|---|----|---|----|---|----|---|
| 1 | A | B | C | D | E | F | G | H | I | J | K | L | M |
| 2 | | 6 | | 5 | | 4 | | 3 | ● | 2 | | 1 | |
| 3 | | | | | | | | | ● | | | | |
| 4 | | 7 | | 8 | | 9 | | 10 | | 11 | | 12 | |
| 5 | | | | | | | | | | | | | |
| 6 | | 18 | | 17 | | 16 | | 15 | | 14 | | 13 | |
| 7 | | | | | | | | | | | | | |
| 8 | | 19 | | 20 | | 21 | | 22 | | 23 | | 24 | |
| 9 | | | | | | | | | | | | | |
| 10 | | 30 | | 29 | | 28 | | 27 | | 26 | | 25 | |
| 11 | | | | | | | | | | | | | |
| 12 | | 31 | | 32 | | 33 | | 34 | | 35 | | 36 | |
| 13 | | | | | | | | | | | | | |

NOTE: Not more than 2 corners, all in the same town and range, may be recorded on this certificate.

A. Description of original monument and accessories and/or subsequent restoration:

| | | | |
|------|--|------|---|
| I-2 | GLO – set quarter section post - Lewis Clawson, D.S. 1839. | I-3 | GLO – set corner post – Lewis Clawson, D.S. 1839. |
| Wit: | Hemlock 15" N 34° W 16 links | Wit: | Hemlock 22" S 44° E 42 links |
| | Hemlock 10" S 42° E 20 links | | Beech 8" N 22° W 22 links |

Marcus Schaaf, RLS #3104, set a 2" pipe while working in the area c. 1940.

Duane R. MacNeil, RLS #19237, found a 1" pipe for this corner while doing a survey in Section 11 on August 20, 1980.

| | | | |
|------|--------------|---------|--------|
| Wit: | Fence corner | North | 33.44' |
| | Fence post | N 85° E | 30.57' |
| | Fence corner | S 50° E | 44.84' |


B. Description of corner evidence found and/or method applied in restoring or reestablishing corner:

| | | | |
|-----|--|-----|------------------------------------|
| I-2 | Found and accepted a 2" iron pipe set by Marcus Schaaf, RLS #3104. | I-3 | Found and accepted a 1" iron pipe. |
|-----|--|-----|------------------------------------|

C. Description of monument for corner and accessories established to perpetuate locating the position of the corner:

| | | | |
|------|--|------|--|
| I-2 | Found a 2" iron pipe. Set a carsonite marker post. | I-3 | Found a 1" iron pipe. Set a carsonite marker post. |
| Wit: | Set nail in 10" Cherry S 51° E 21.82' | Wit: | Set nail in 20" Red Pine S 37° E 58.79' |
| | Set nail in 4" Oak N 77° E 18.55' | | Set nail in 18" Red Pine S 39° W 78.56' |
| | Set nail in 10" Ash N 6° W 29.27' | | Set nail in 16" Red Pine S 78° W 106.44' |
| | Set nail in 6" Ash S 87° W 9.84' | | Set nail in 9" Red Pine N 18° E 83.24' |
| | Carsonite post North 1' | | Carsonite post North 1' |

Signed by Carl T Kiiskila
 Surveyor's Michigan License No. 33981

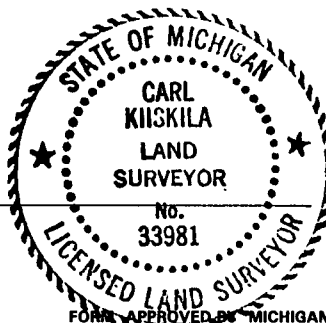

Date 8-12-99