

FEB 17 1994

COLLARED CORNER RECORDATION CERTIFICATE

FILING REQUIREMENT OF ACT 74, MICH. P.A.1970

181
200

FOR CORNERS OF--:	LOCATED IN--:	CORNER CODE NUMBER
1. PUBLIC LAND SURVEY <u>24</u> T. <u>30</u> ^{N.} S. , R. <u>8</u> ^{E.} W.		<u>K-9</u>
2. PROPERTY CONTROLLING IN SECTION _____, T. _____, S., R. _____, E. _____, W. _____		
3. MISCELLANEOUS PROPERTY IN SECTION _____, T. _____, S., R. _____, E. _____, W. _____		
4. LOT NO. _____, RECORDED PLAT _____		
5. PRIVATE CLAIMS _____		

ANTRIM COUNTY
 MICHIGAN
 RECEIVED FOR RECORD
 93 DEC 14 AM 10:55
 REGISTER OF DEEDS
 REGISTER OF DEEDS STAMP AND FILING NUMBER

I, Terry B. Smith, do hereby certify that under requirements of P.A. 74, Michigan P.A. of 1970, the corner points mentioned in lines 1 and 2 above were, in a field survey on Dec. 6, 1993, established, re-established, monumented, re-monumented, recovered or restored as expressed below and in conformance with regulations and rules therefore as required in the current manual of survey instructions of the United States Department of the Interior, Bureau of Land Management or by a decree of a court of law. Furthermore, that the corner points mentioned in lines 3, 4 and 5 above were, in a field survey on Dec. 6, 1993, found, recovered, restored, established or re-established as expressed below and in conformance with the rules of the Michigan State Board of Registration for Land Surveyors or, by a Decree of a Court of law:

A. Description of original monument and accessories and/or subsequent restoration:

1855 post set
 Hemlock 20 N43W 8L
 Cedar 20 N43W 52L

Oct. 18, 1963 certificate by Robert Findorff, PE#12165
 States he set a corner at the location of K-9

B. Description of corner evidence found and/or method applied in restoring or re-establishing corner:

Corner recorded Liber 199 page 239
 Found old Antrim County Monument -- cap missing and base bent and rusted -- appeared as a "pipe"
 Peer group approval to set new monument at location

C. Description of monument for corner and accessories established to perpetuate locating the position of the corner:


Set Antrim County Monument
 K-9 SW Corner Section 24, T30N, R8W
 16" Maple S10°E 64.50
 Utility pole S50°W 132.31
 Utility pole N50°E 68.12

SIGNED BY Terry B. Smith

DATE _____

SURVEYOR'S MICHIGAN REGISTRATION NO. 25873

FOR STATE AND UNITED STATES AGENCIES:

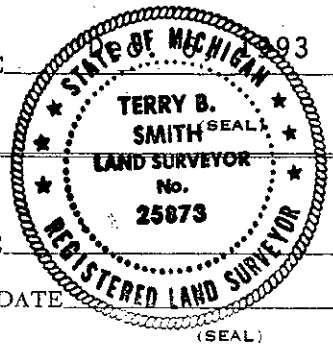

SIGNED BY _____

DATE _____

CHIEF OF SURVEY PARTY

APPROVED AND SIGNED BY _____

DATE _____

MICHIGAN REGISTERED LAND SURVEYOR

SURVEYOR'S MICHIGAN REGISTRATION NO. _____