

DEC 4 2 24 PM '96

LAND CORNER RECORDATION CERTIFICATE  
Filing Requirement of Act 74, Mich. P.A. 1970

*Wanda L. Quinlan*  
REGISTER OF DEEDS

For corners in

(County)	Located In:	Corner Code #
1. Public Land Survey	T 30N R 9W	I-1
	T R	
	T R	
	T R	
2. Property Controlling in Section	S T R	
	S T R	
3. Miscellaneous Property in Sec.	S T R	
	S T R	

Register of Deeds Stamp & File Number

4. Lot No. \_\_\_\_\_, Recorded Plat \_\_\_\_\_  
5. Private Claims \_\_\_\_\_

I, Terry B. Smith, in a field survey on Nov. 18, 1996 do hereby state that under requirements of P.A. 74, Michigan P.A. of 1970, the corner points mentioned in lines 1 and 2 above were in conformance with regulations and rules therefore as required in the current manual of survey instructions of the United States Department of the Interior, Bureau of Land Management or by a decree of a Court of Law and /or that the corner points mentioned in lines 3, 4 and 5 above were in conformance with the rules of the Michigan Board of Land Surveyors or by a Decree of a Court of Law; established, re-established, monumented, recovered, found as expressed below:

NOTE: Not more than 2 corners, all in the same town and range, may be recorded on this certificate.

	A	B	C	D	E	F	G	H	I	J	K	L	M
1									●				
2	6		5		4			3		2		1	
3													
4	7		8		9			10		11		12	
5													
6	18		17		16			15		14		13	
7													
8	19		20		21			22		23		24	
9													
10	30		29		28			27		26		25	
11													
12	31		32		33			34		35		36	
13													

A. Description of original monument and accessories and/or subsequent restoration:

May. 25, 1839  
GLO Ran West on south line of Section 35  
GLO Did Not Establish  
notes pertain to south line of T31N, R9W  
land level and swampy


B. Description of corner evidence found and/or method applied in restoring or reestablishing corner:

Oct 23, 1958 recorded plat of North Golden Beach  
Liber 2 of plats page 99  
Corner found -- 1" Pipe at plat distance

C. Description of monument for corner and accessories established to perpetuate locating the position of the corner:

Set Antrim County Monument  
8" Poplar S30E 16.00  
6" Poplar N50W 3.90  
6" Poplar N70E 15.20  
6" Apple S70W 18.25

Ratified by Peer Group  
in accordance with  
PO 345.  
Antrim County Chairman  
*Arthur L. Lennox*  
Arthur L. Lennox  
Nov. 26, 1996

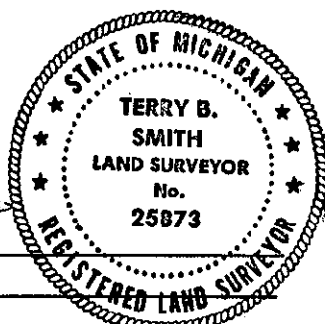

Signed by *Terry B. Smith*  
Surveyor's Michigan License No. 25873

Date Dec. 3, 1996

98

002 334