

Dec 4 2 24 PM '96

*Wanda R. Conroy*

REGISTER OF DEEDS

LAND CORNER RECORDATION CERTIFICATE  
Filing Requirement of Act 74, Mich. P.A. 1970

For corners in

_____	Located In:	Corner Code #
(County)		
1. Public Land Survey	T <u>30</u> NR <u>9</u> W	<u>I-2</u>
	T _____ R _____	_____
	T _____ R _____	_____
	T _____ R _____	_____
2. Property Controlling in Section	S _____ T _____ R _____	_____
	S _____ T _____ R _____	_____
3. Miscellaneous Property in Sec.	S _____ T _____ R _____	_____
	S _____ T _____ R _____	_____

Register of Deeds Stamp & File Number

4. Lot No. \_\_\_\_\_, Recorded Plat \_\_\_\_\_  
5. Private Claims \_\_\_\_\_

I, Terry B. Smith, in a field survey on Nov. 18, 1996 do hereby state that under requirements of P.A. 74, Michigan P.A. of 1970, the corner points mentioned in lines 1 and 2 above were in conformance with regulations and rules therefore as required in the current manual of survey instructions of the United States Department of the Interior, Bureau of Land Management or by a decree of a Court of Law and/or that the corner points mentioned in lines 3, 4 and 5 above were in conformance with the rules of the Michigan Board of Land Surveyors or by a Decree of a Court of Law, established, re-established, monumented, recovered, found as expressed below:

NOTE: Not more than 2 corners, all in the same town and range, may be recorded on this certificate.

	A	B	C	D	E	F	G	H	I	J	K	L	M
1													
2	6			5			4		3	2			1
3													
4	7			8			9		10	11			12
5													
6	18			17			16		15	14			13
7													
8	19			20			21		22	23			24
9													
10	30			29			28		27	26			25
11													
12	31			32			33		34	35			36
13													

A. Description of original monument and accessories and/or subsequent restoration:


GLO Ran North between Sections 2 & 3, Var 3°E  
40.00 set 1/2 Sec. post  
B. Ash 12 S5W 22  
Elm 12 N5E 11  
intersect North Town Line 15 ch. 71 Lks  
East of Old Corner, Set Post

B. Description of corner evidence found and/or method applied in restoring or reestablishing corner:

no mention of corner in records  
Established at single prorated distance  
between section corners.

C. Description of monument for corner and accessories established to perpetuate locating the position of the corner:

Set Antrim County Monument  
6" B. Ash S85W 22.36  
10" Poplar North 22.89  
6" B. Ash N45E 26.72  
6" B. Ash S58E 14.80  
Water depth approx 3 ft.

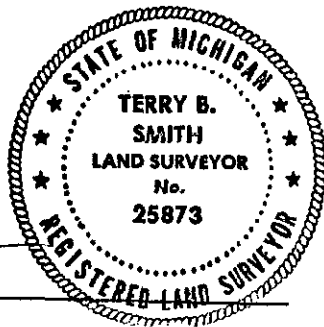

Ratified by Peer Group  
in accordance with  
PO 345.  
Antrim County Chairman  
*Arthur L. Lennox*  
Arthur L. Lennox  
Nov. 26, 1996

Signed by *Terry B. Smith*  
Surveyor's Michigan License No. 25873

Date Dec. 3, 1996

002 333

97